


NDSPLS 33rd Annual Convention
February 8, 2012
Ramada Grand Dakota Lodge & Conference Center
Dickinson, ND

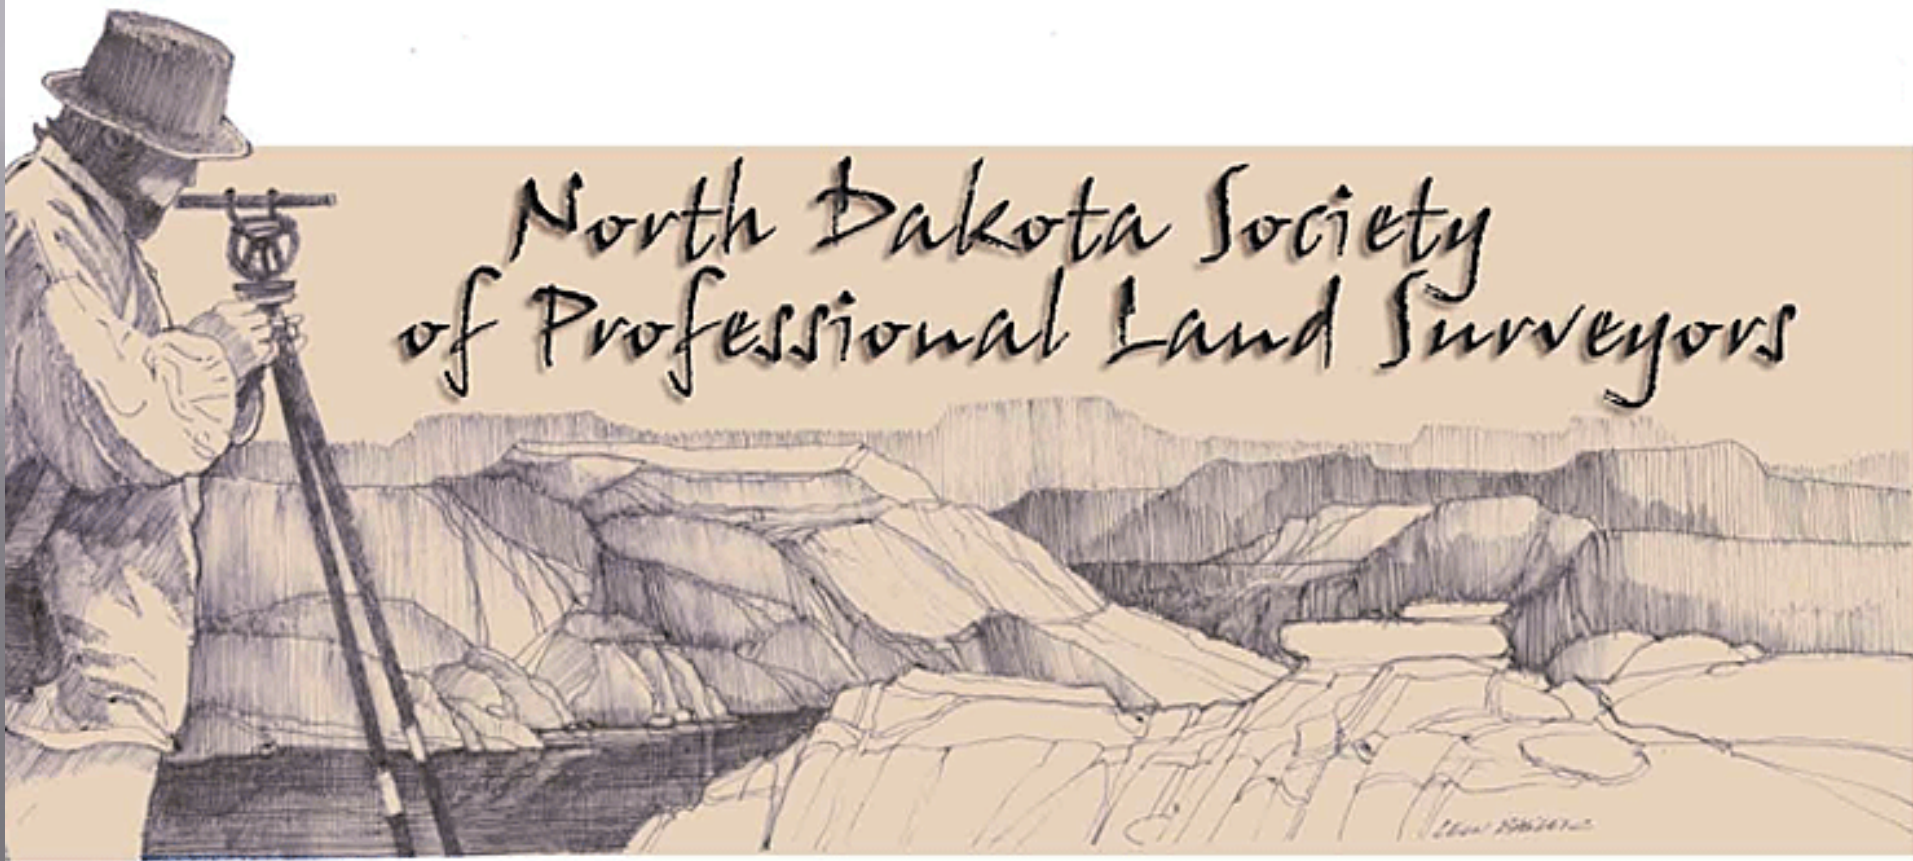


NORTH DAKOTA

- *HORIZONTAL WELL BASICS
 - STAGE FRACKING
- *ACTIVITY
- *NDIC PERMITTING PROCESS
 - PLATS REQUIRED, RULES,
EXAMPLES & RIPARIAN ISSUES.
- *DISTANCE RESTRICTIONS AND
NOTICES

Todd L. Holweger
Permit Manager
NDIC-Oil & Gas Division

North Dakota Department of Mineral Resources

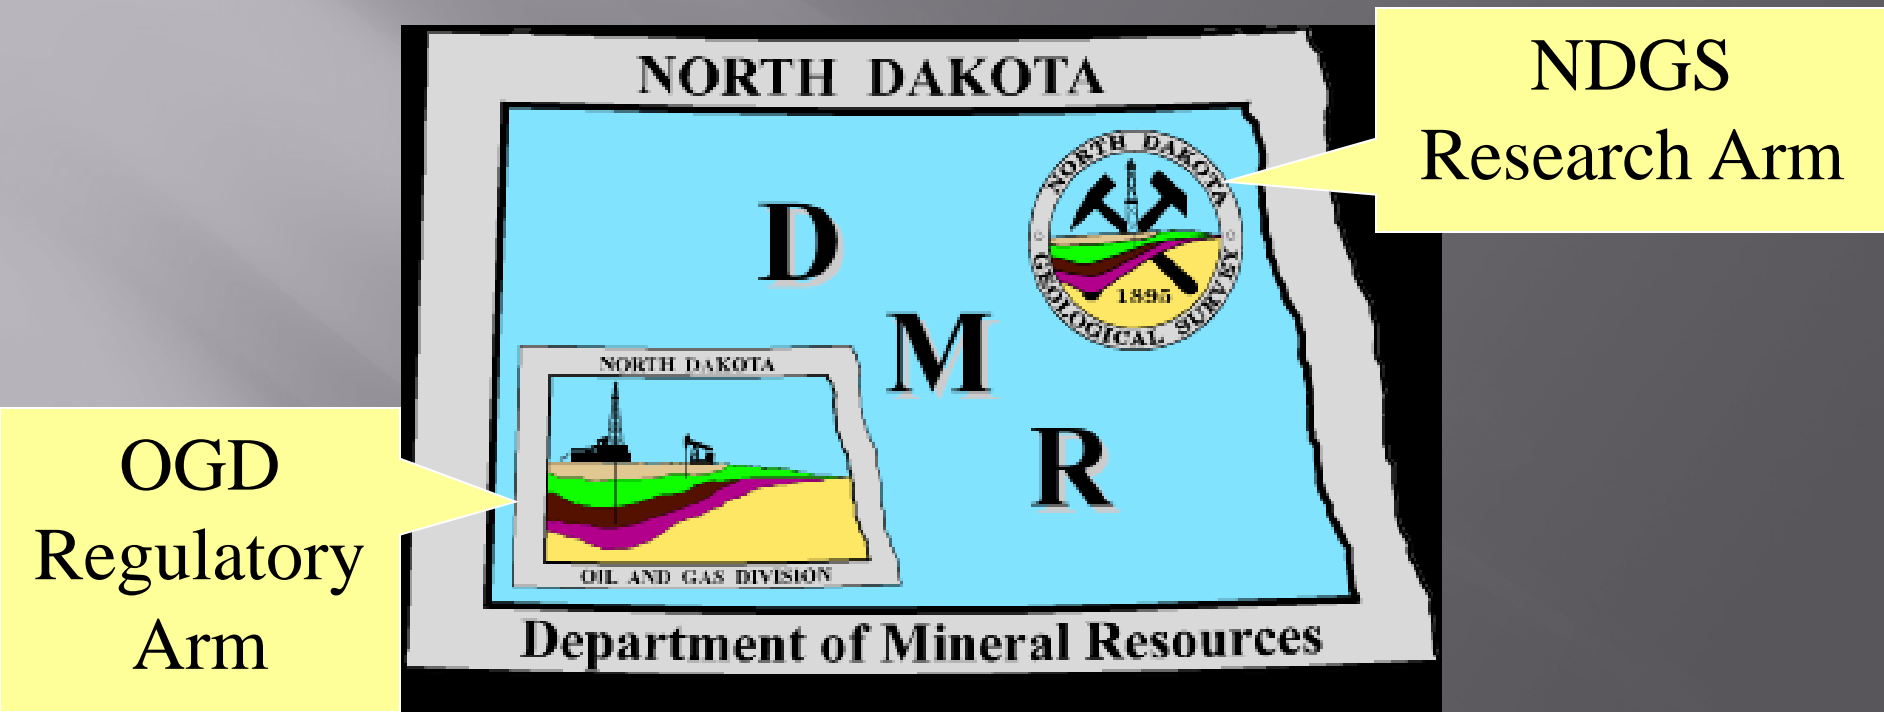

<https://www.dmr.nd.gov/oilgas/>

<https://www.dmr.nd.gov/ndgs/>

600 East Boulevard Ave. - Dept 405

Bismarck, ND 58505-0840

(701) 328-8020

(701) 328-8000

TYPICAL HORIZONTAL OIL WELL

Potable Waters



9-5/8" in 13.5" Hole

- Drill with fresh water
- Total depth below lowest potable water
- Run in hole with surface casing
 - 1st layer of surface water protection
- Cement casing back to surface of ground
 - 2nd layer of surface water protection

TYPICAL HORIZONTAL OIL WELL


Potable Waters

9-5/8" in 13.5" Hole

Kick-off
Point


- Drill vertically to kick-off point
- Run in hole with bent assembly
- Downhole mud motor

TYPICAL HORIZONTAL OIL WELL

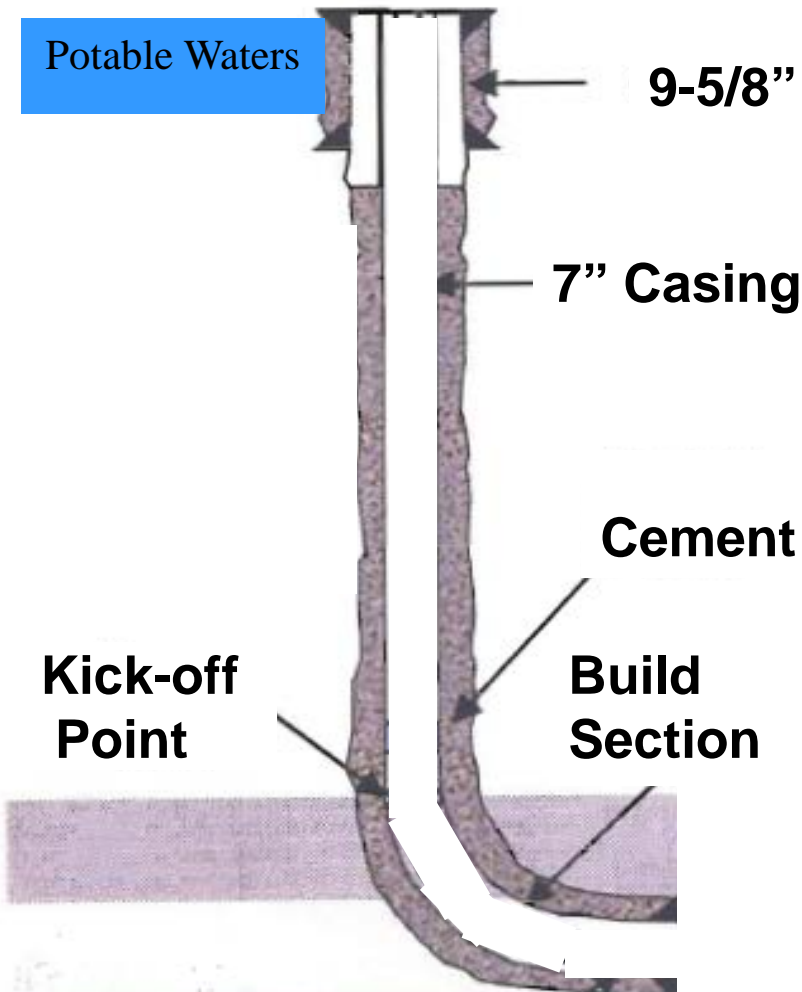


- Drill 8-3/4" hole to pay
- Run in hole with 7" casing
 - 3rd layer of protection
- Cement 7" casing
 - 4th layer of protection


TYPICAL HORIZONTAL OIL WELL

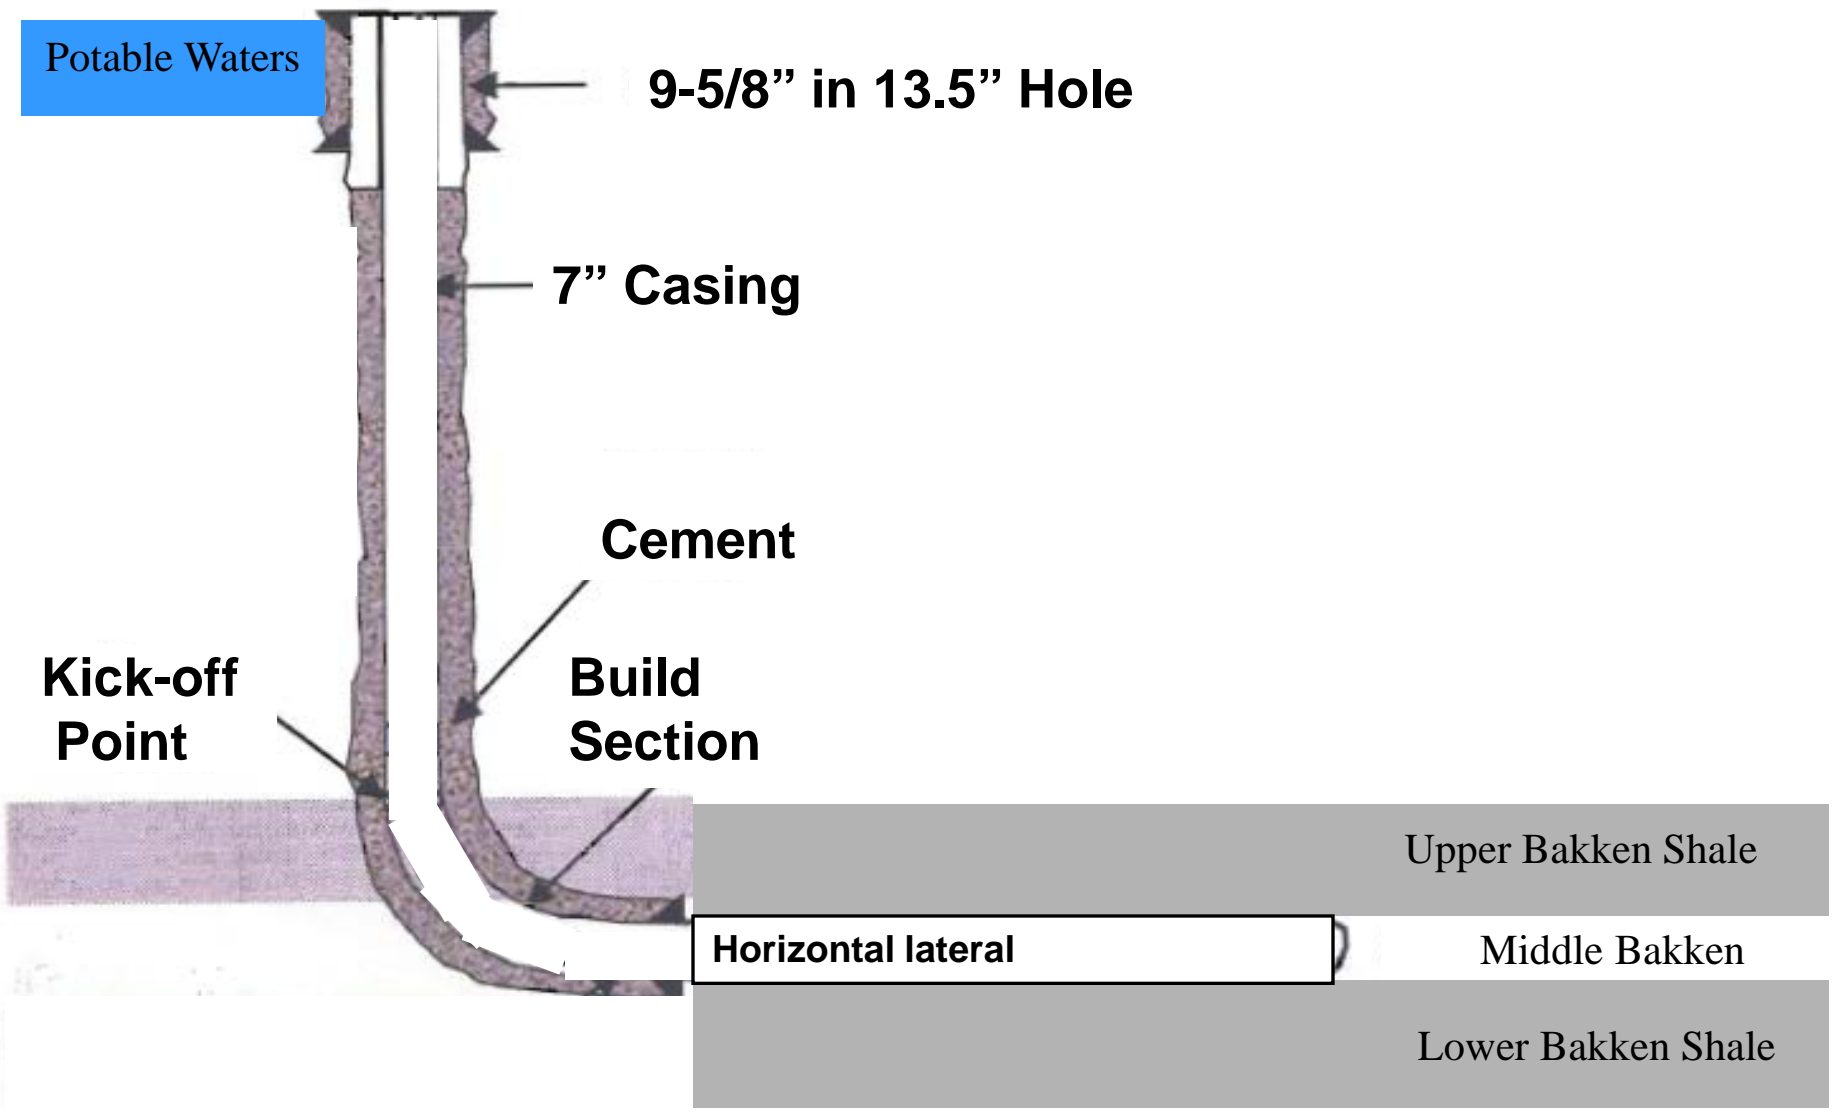


TYPICAL HORIZONTAL OIL WELL

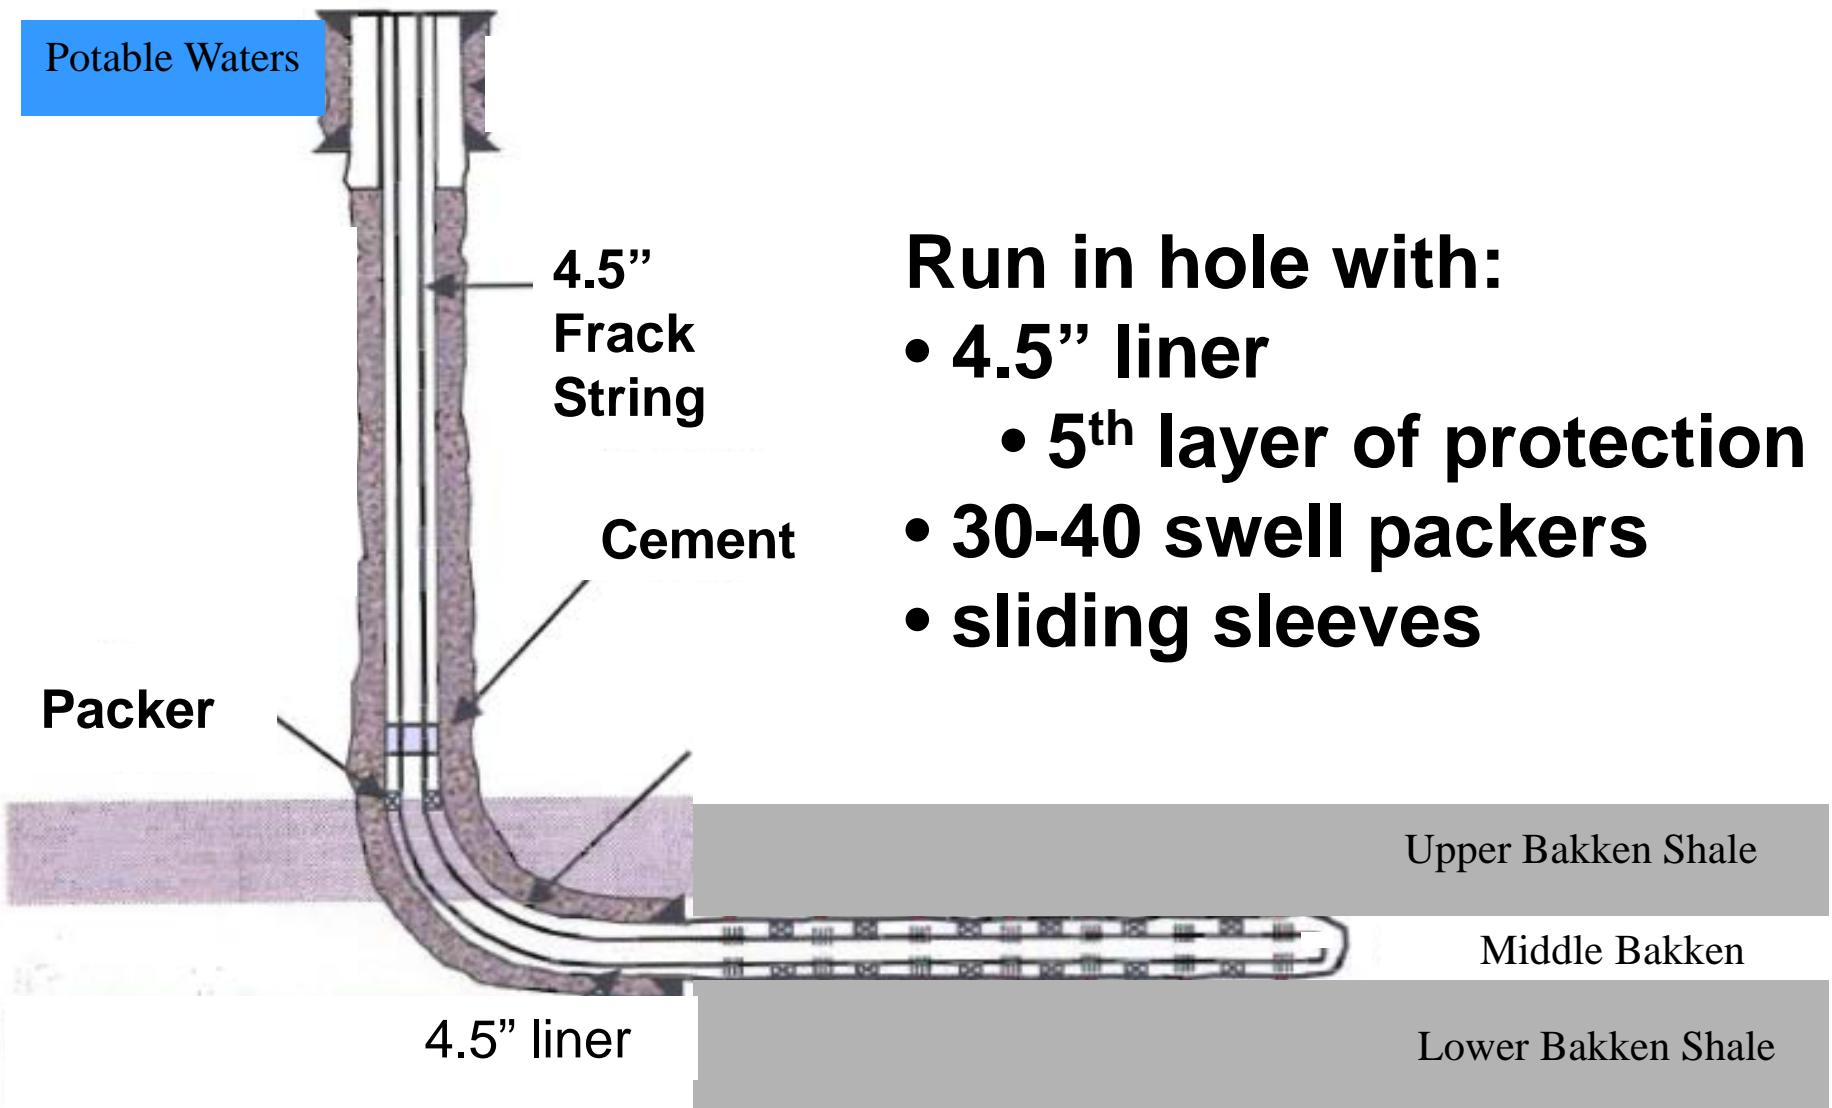


TYPICAL HORIZONTAL OIL WELL

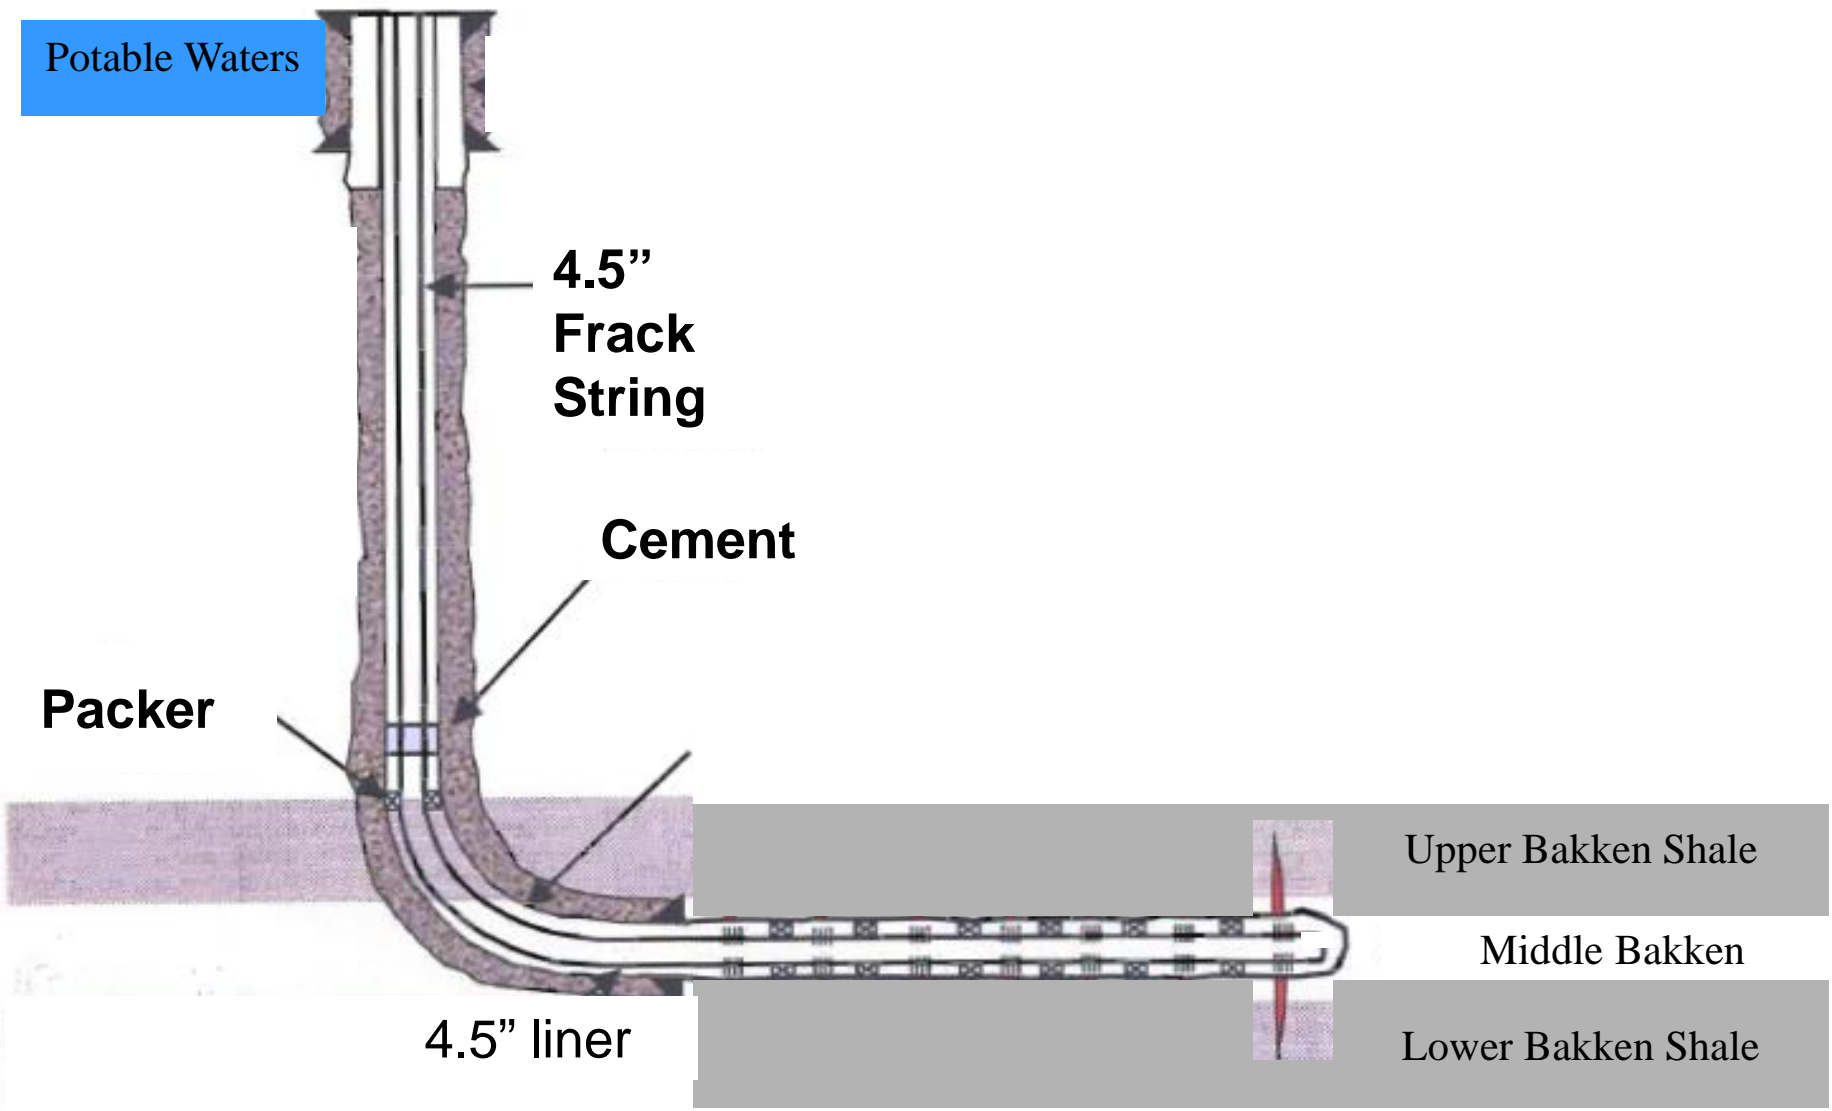


TYPICAL HORIZONTAL OIL WELL

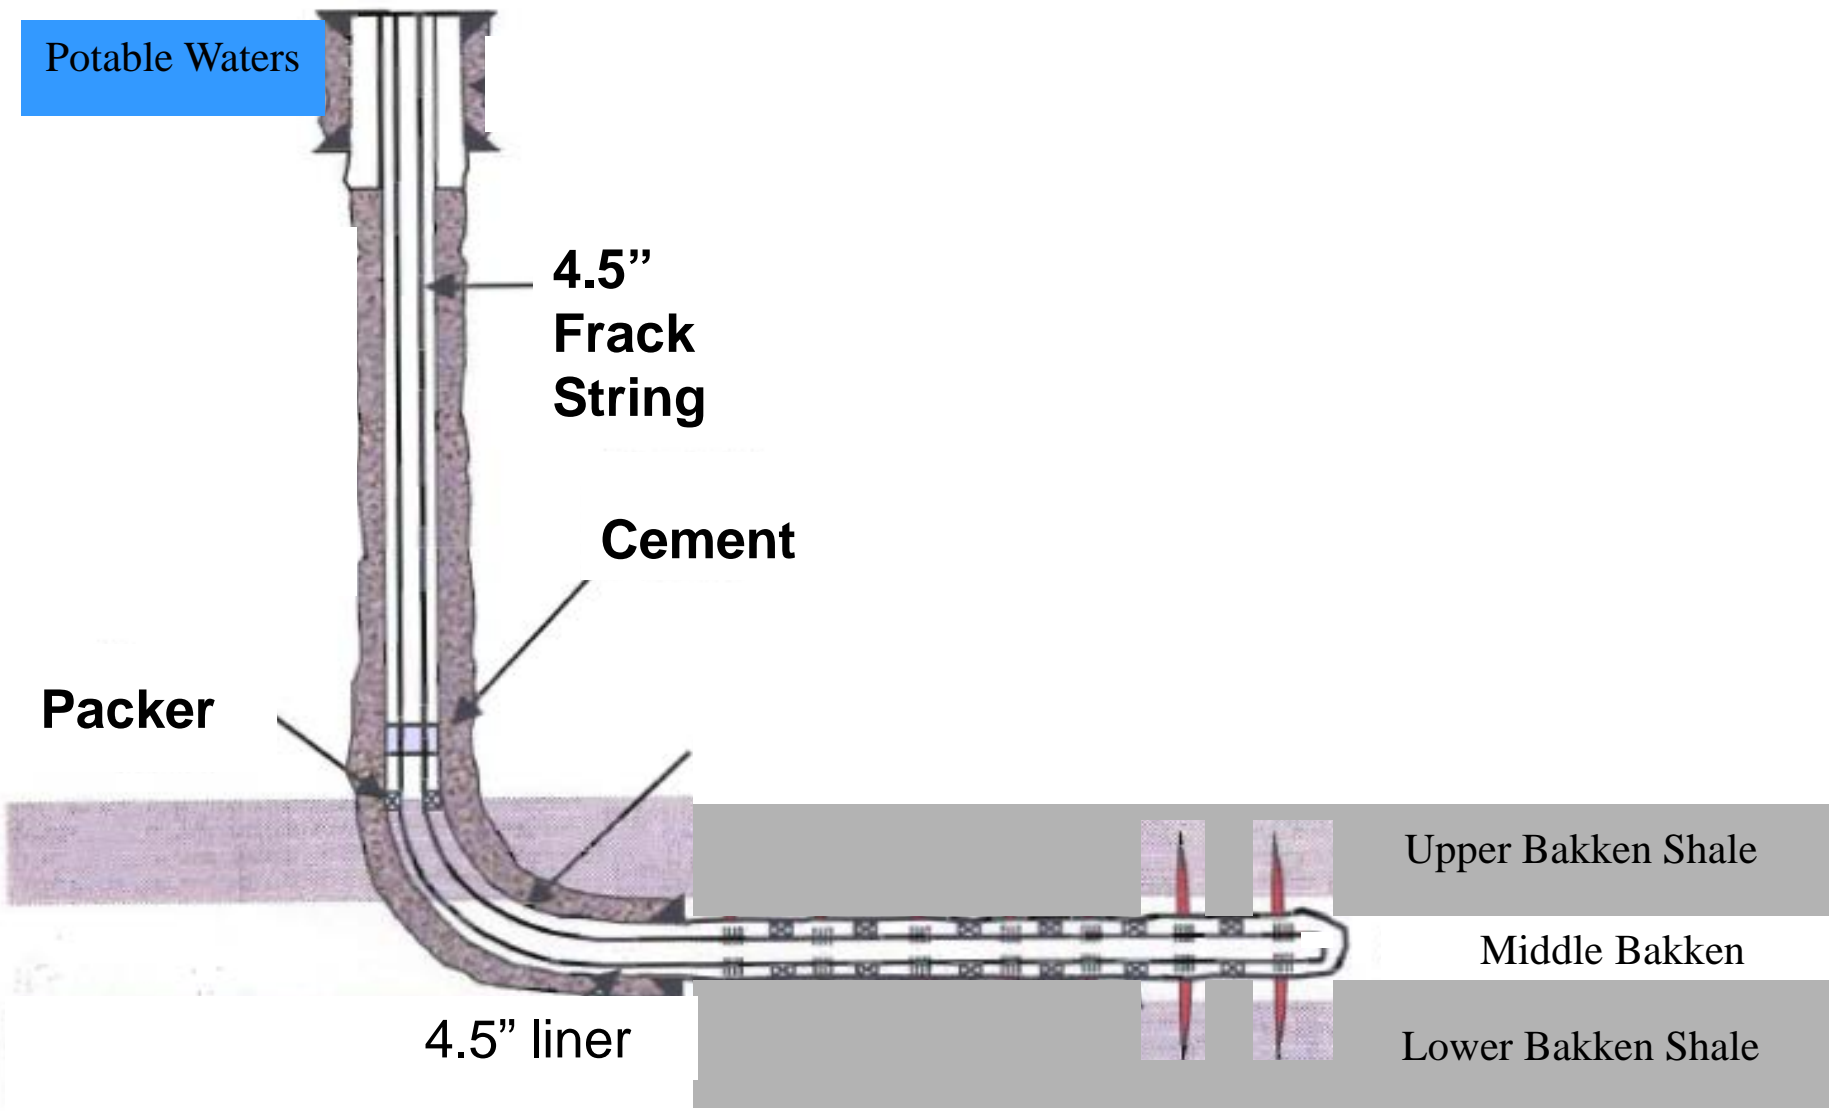


TYPICAL HORIZONTAL OIL WELL

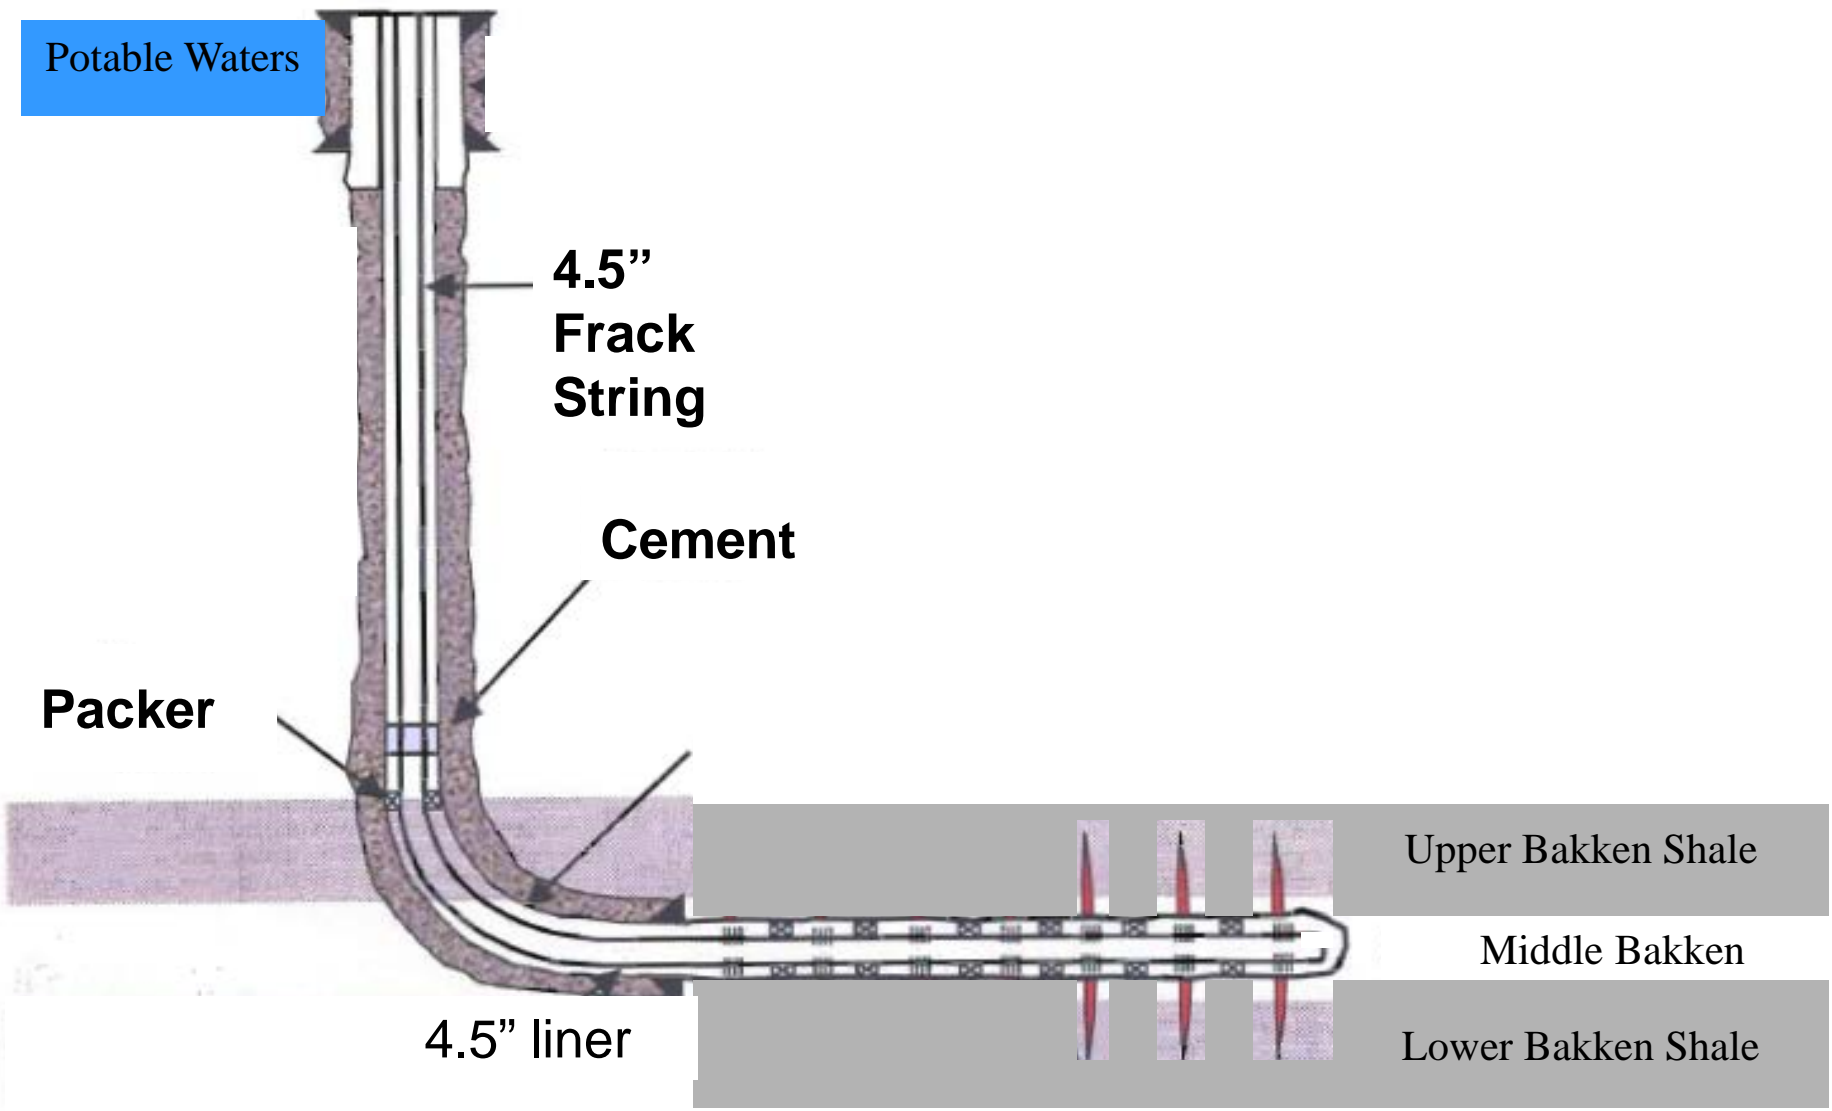


TYPICAL HORIZONTAL OIL WELL

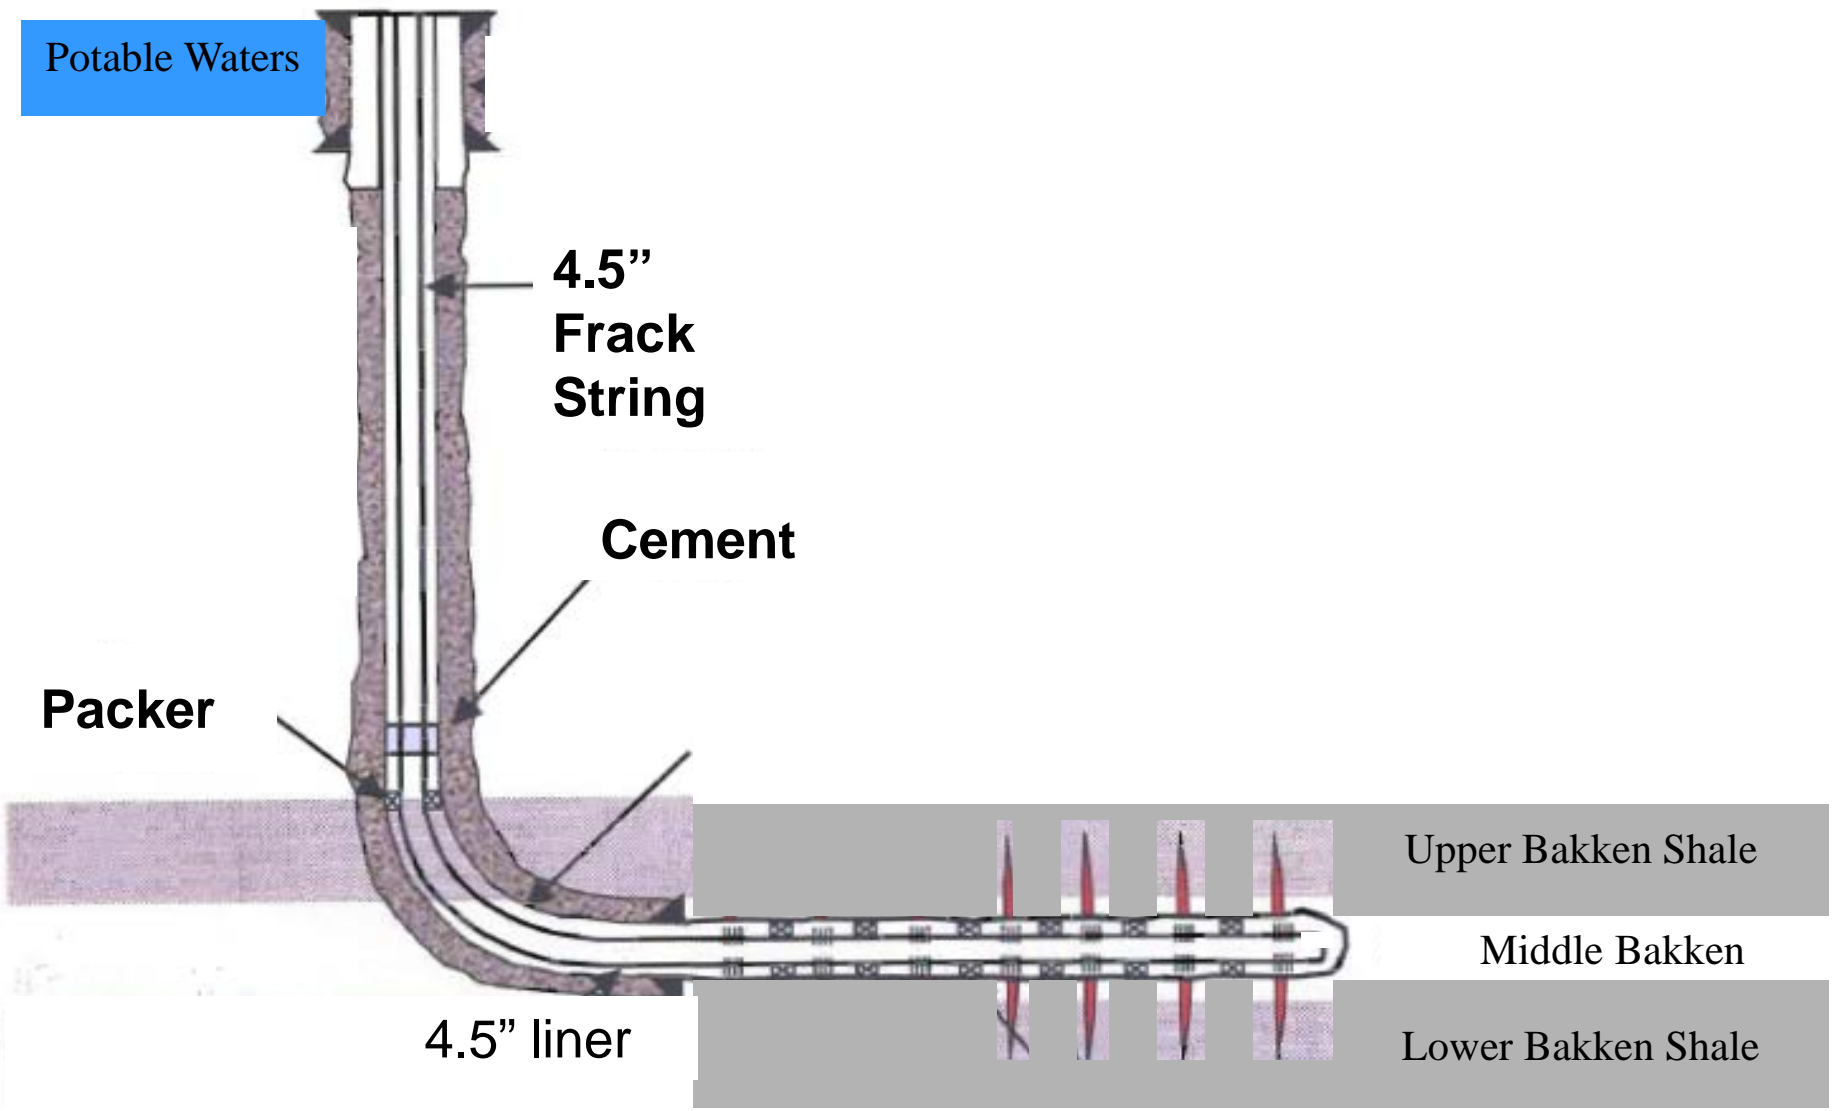

TYPICAL HORIZONTAL OIL WELL

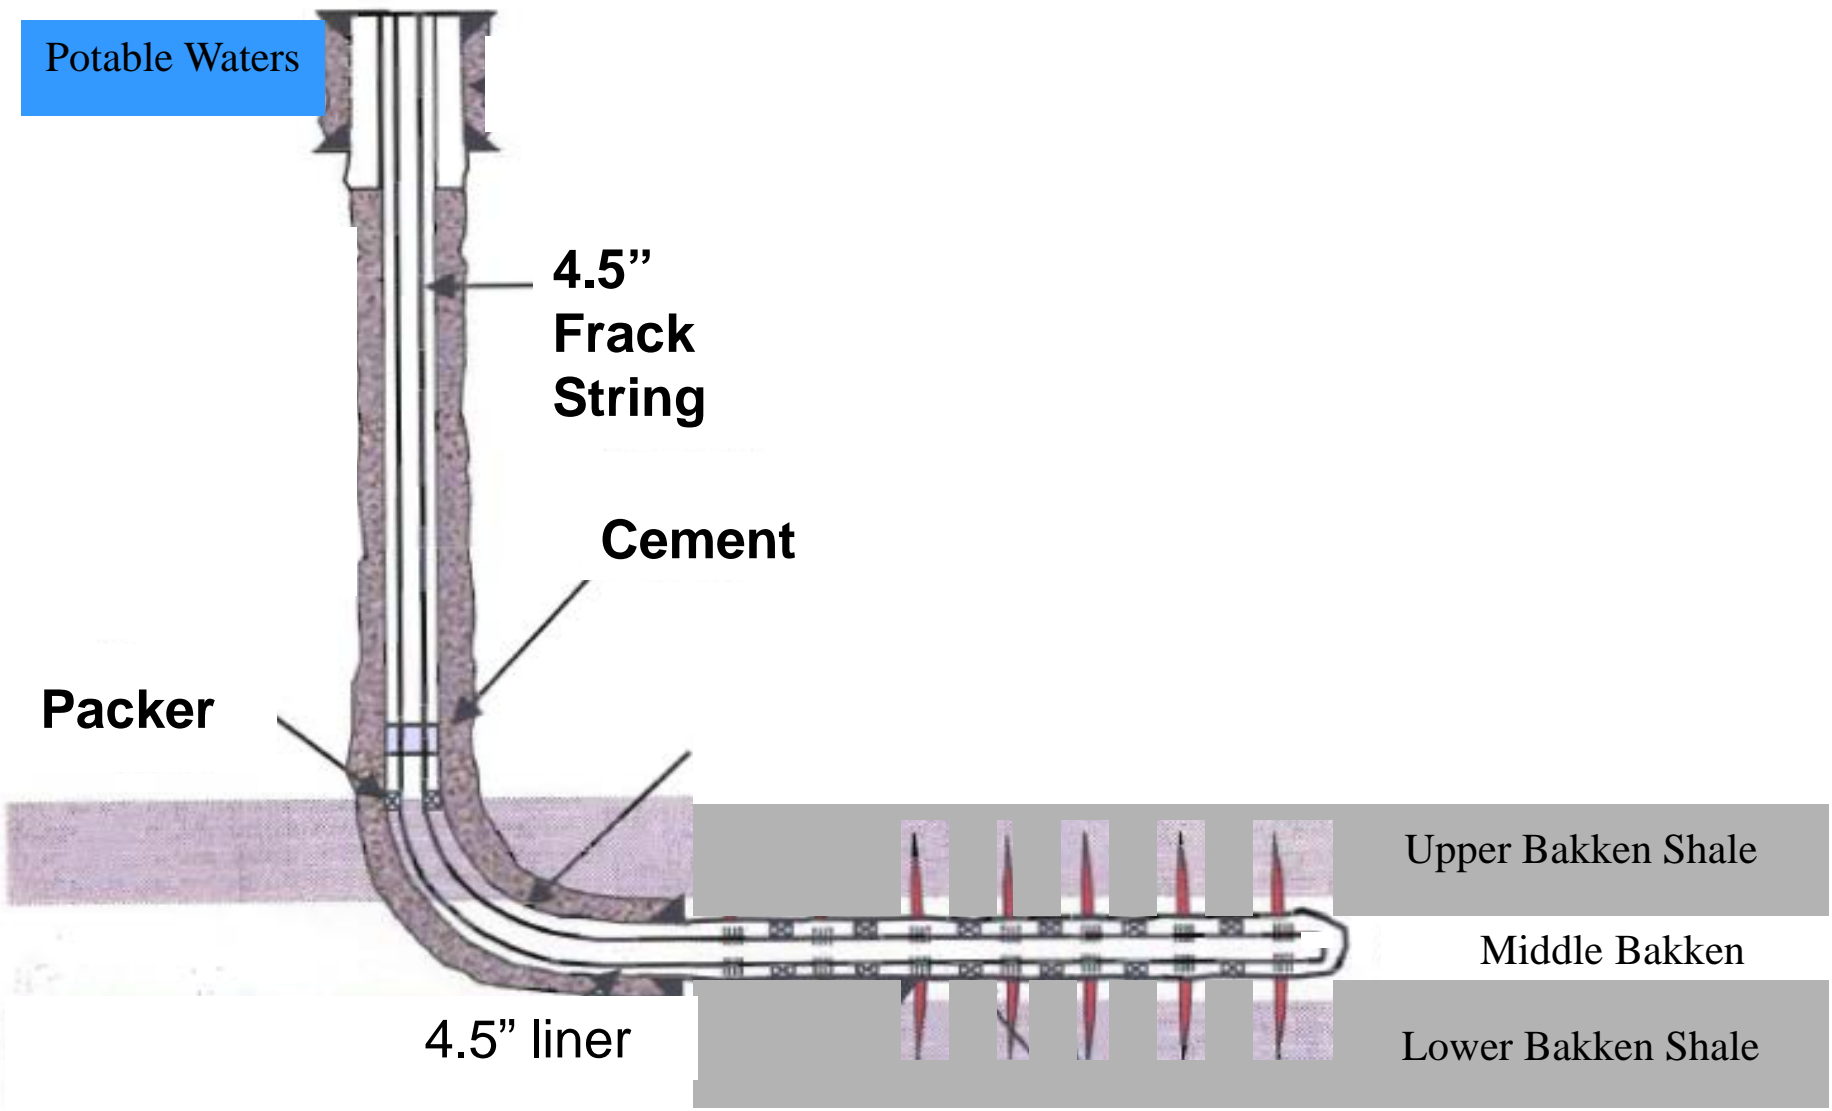

TYPICAL HORIZONTAL OIL WELL

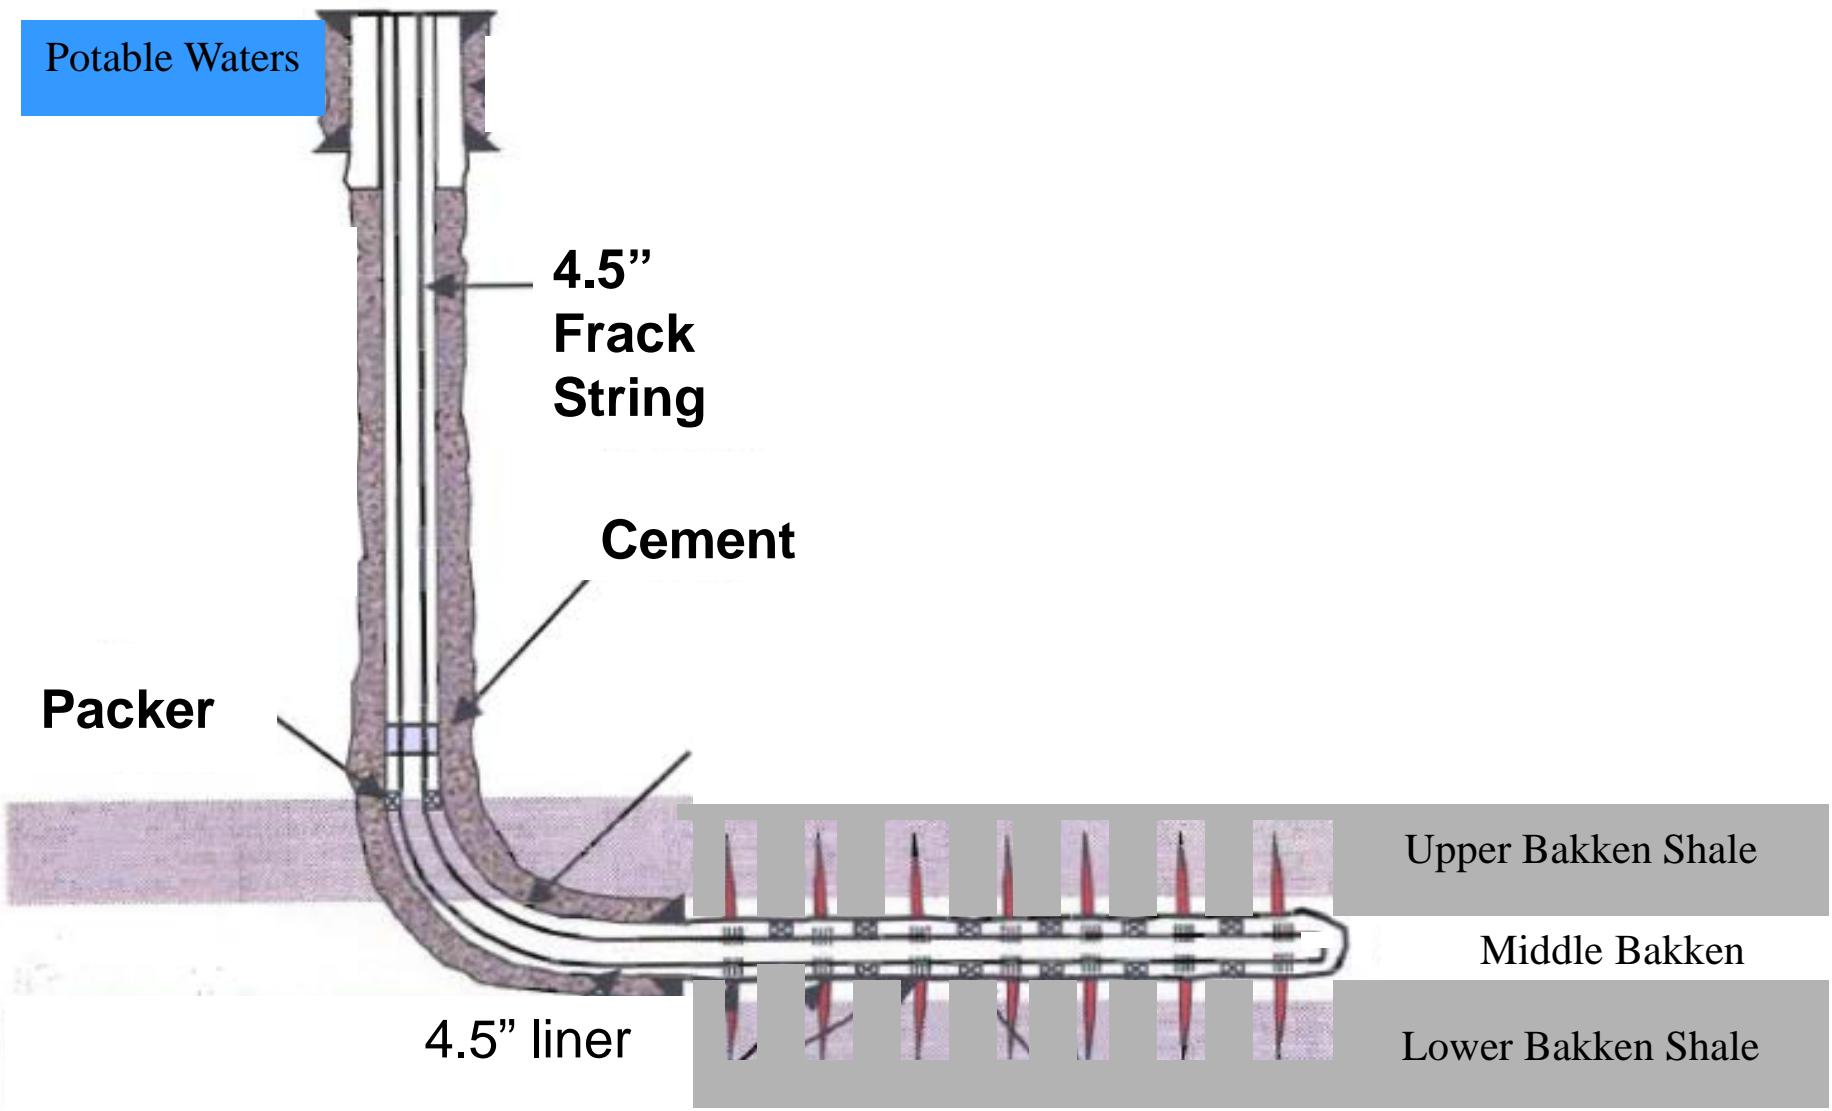




Performing hydraulic fracture stimulation south of Tioga


- all Bakken wells must be hydraulically fractured to produce
- > 2 million gallons of water
- > 3 million pounds of sand
- cost > \$2 million

WHY FRACK THE ROCK?

- **already developed easy oil**
 - **oil flows easily without fracking**
- **Unconventional Reserves**
 - **reservoirs are tight**
 - **uneconomic to produce w/o fracking**
 - **must create a path for oil to flow**

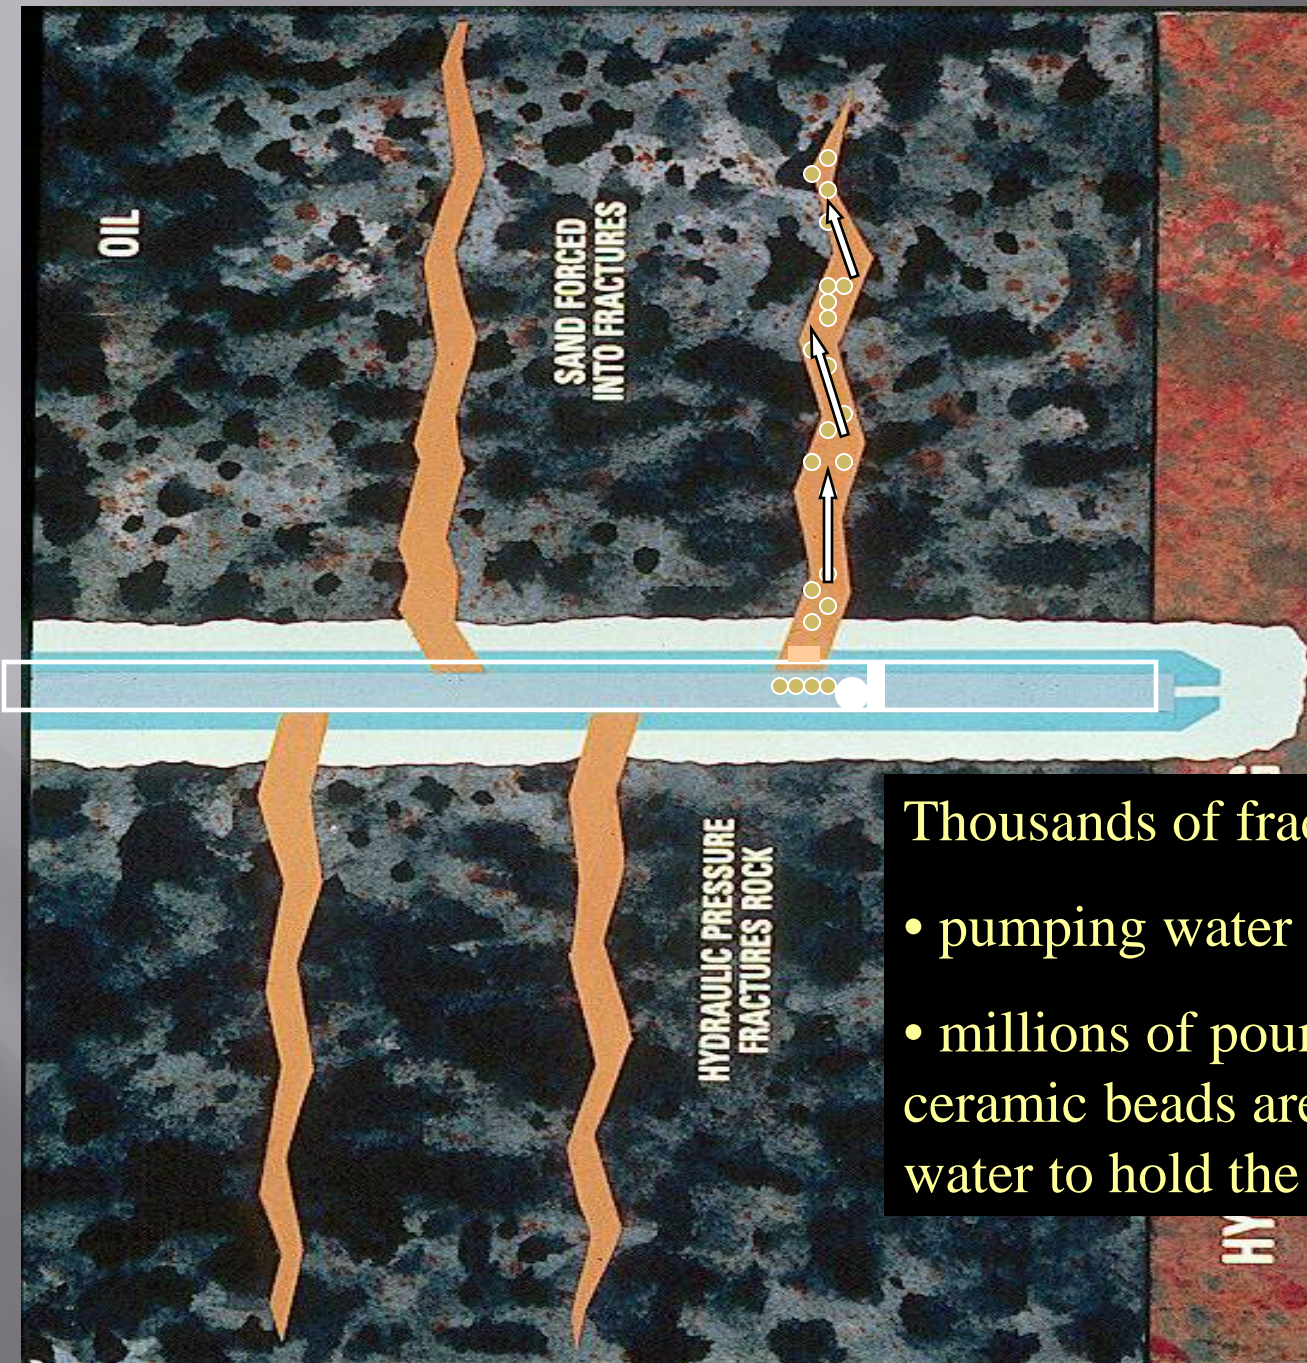



- Thousands of fractures are created
- pumping water at 6,000-9,000 psi
 - millions of pounds of sand and ceramic beads are pumped with the water to hold the fractures open.

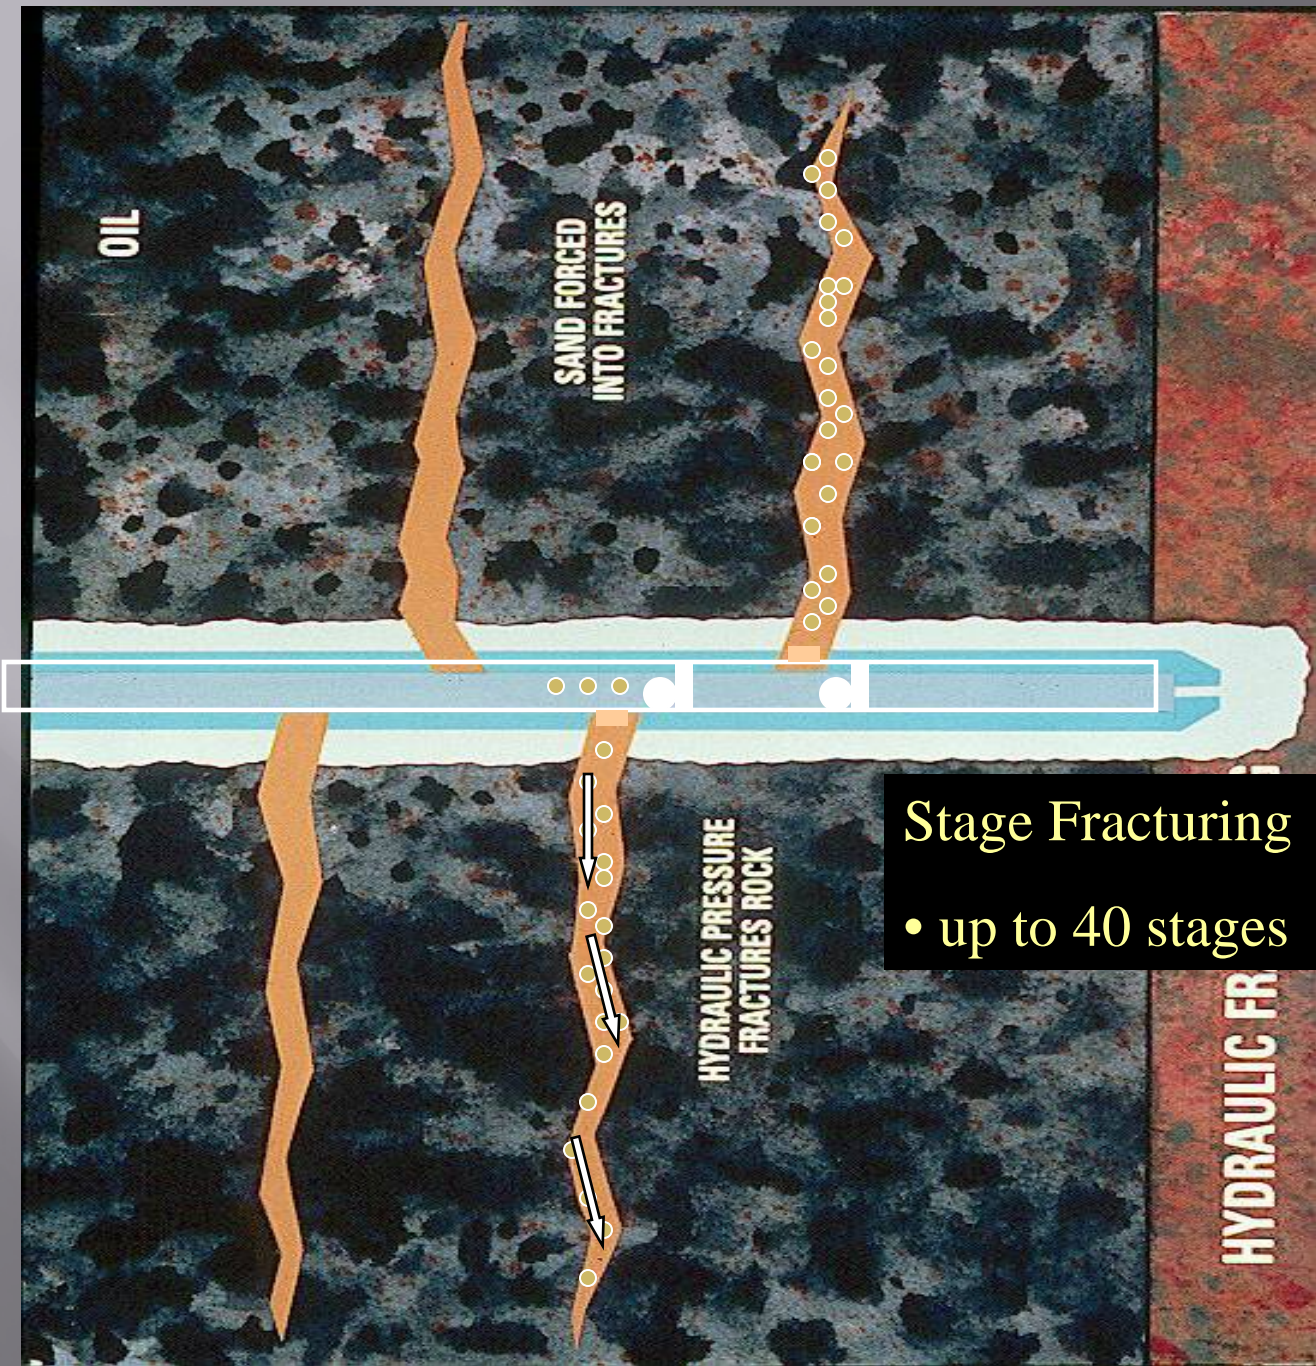


Stage Fracturing

- up to 40 stages

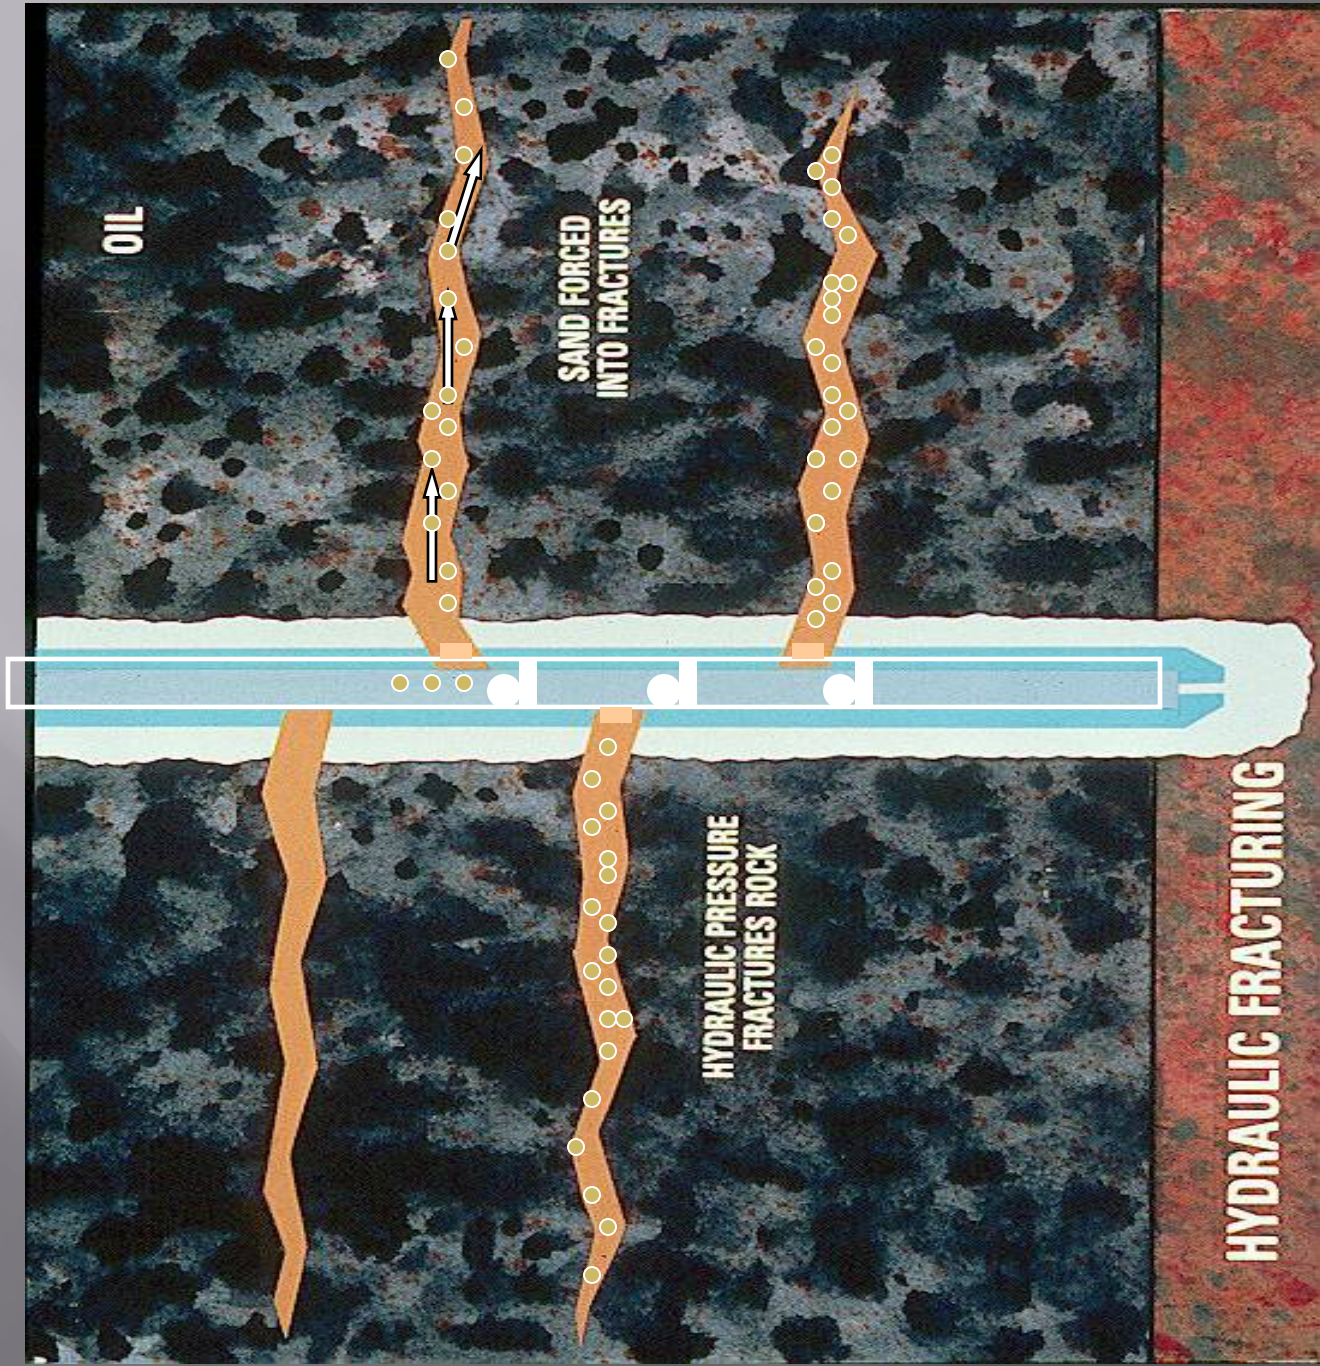

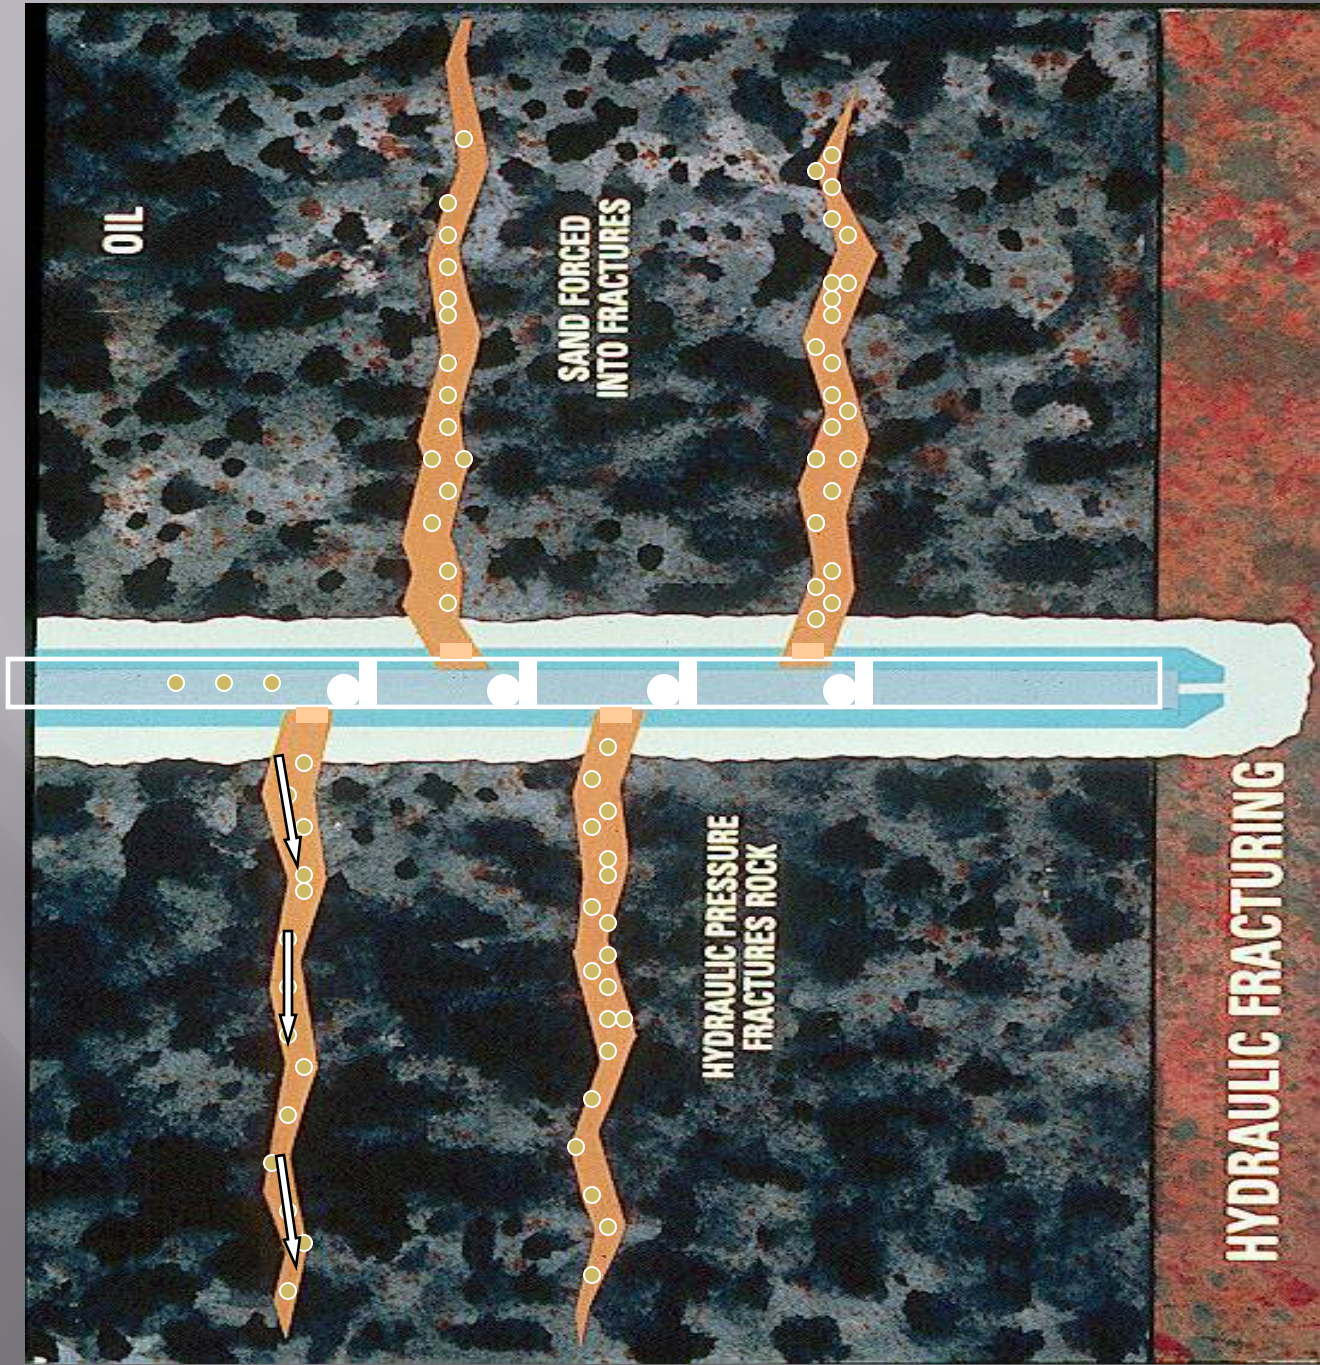

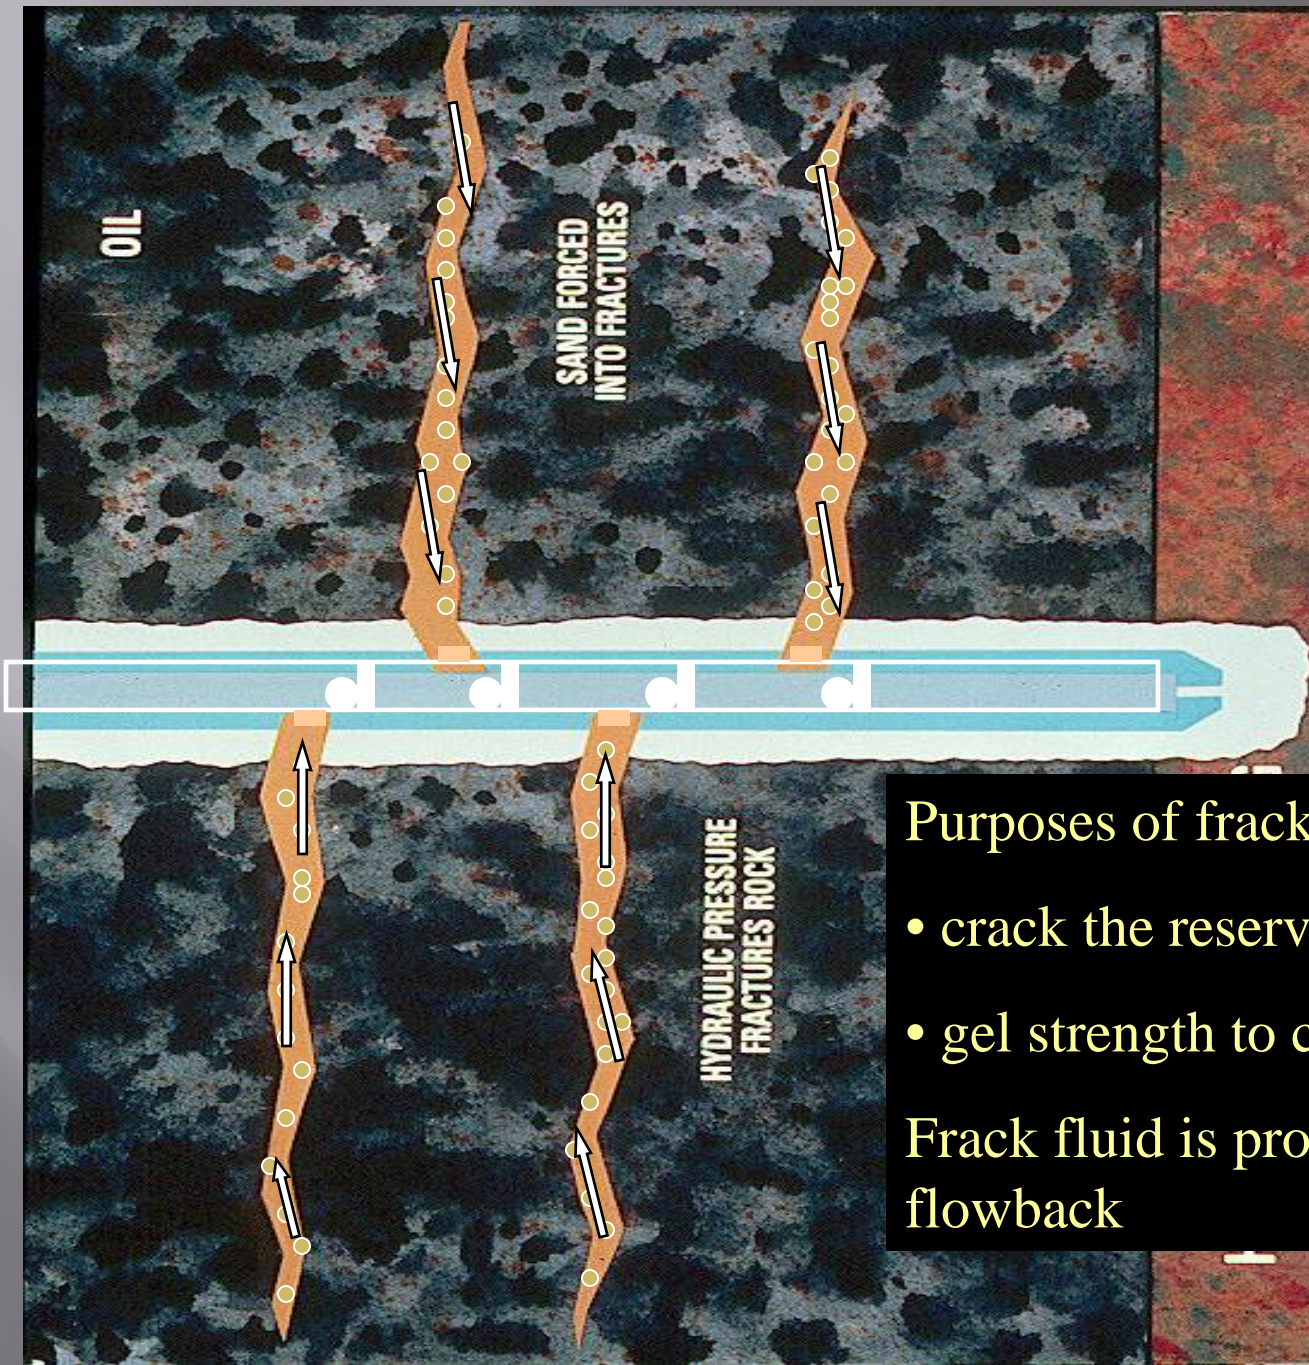


Purposes of frack fluid


- crack the reservoir
- gel strength to carry sand

Frack fluid is produced back as flowback

Hydraulic Fracturing: Mixture of water, sand and chemicals pressurized and pumped into the well to form microscopic fractures in shale.

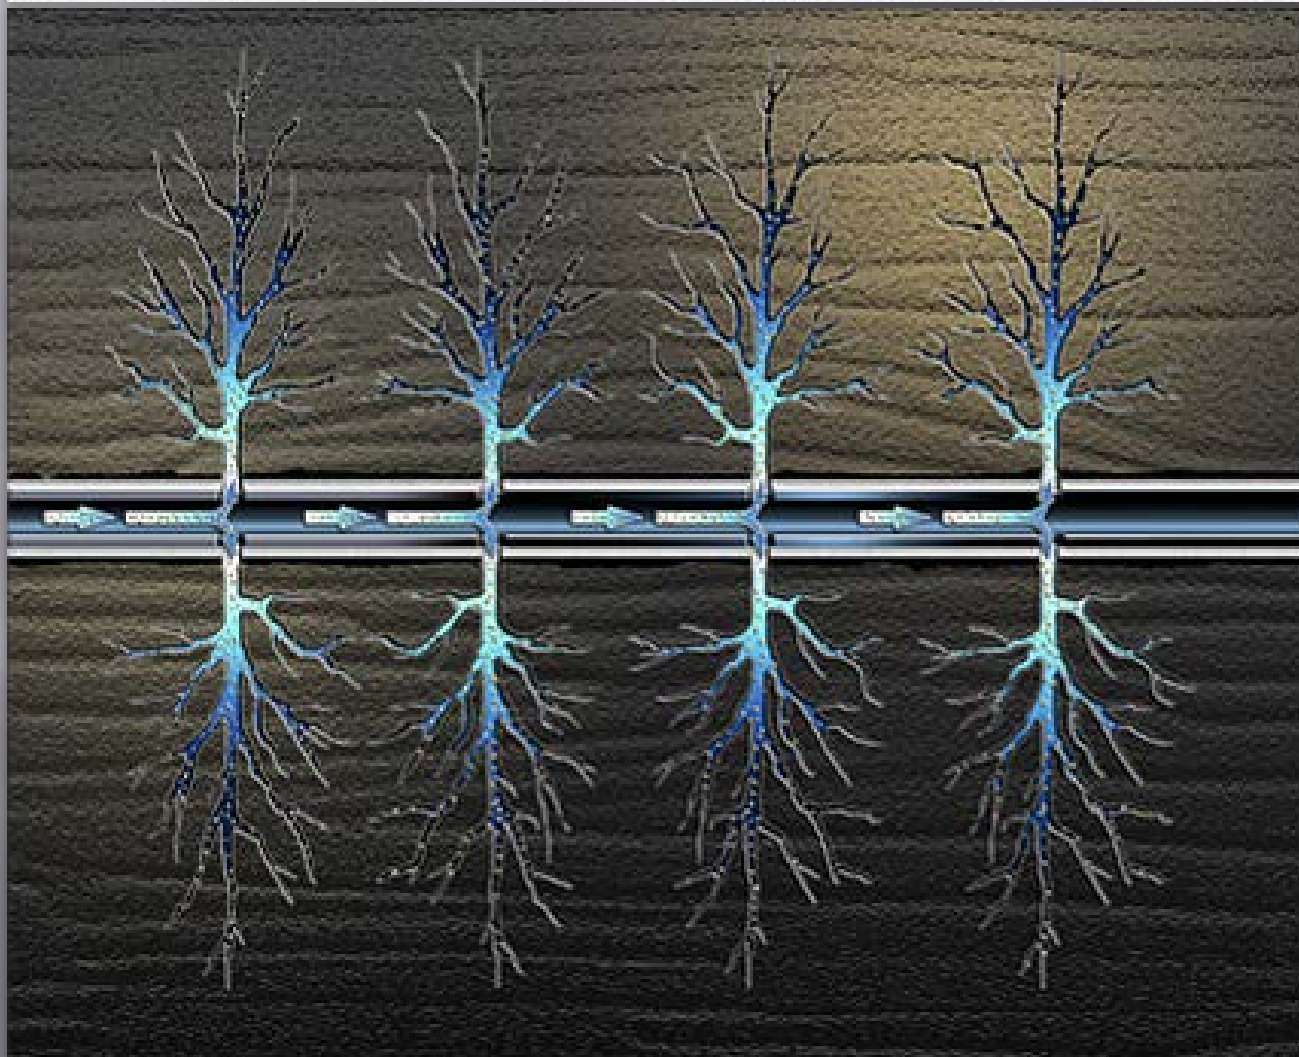


Three-Dimensional Geologic Model of the Parshall Area

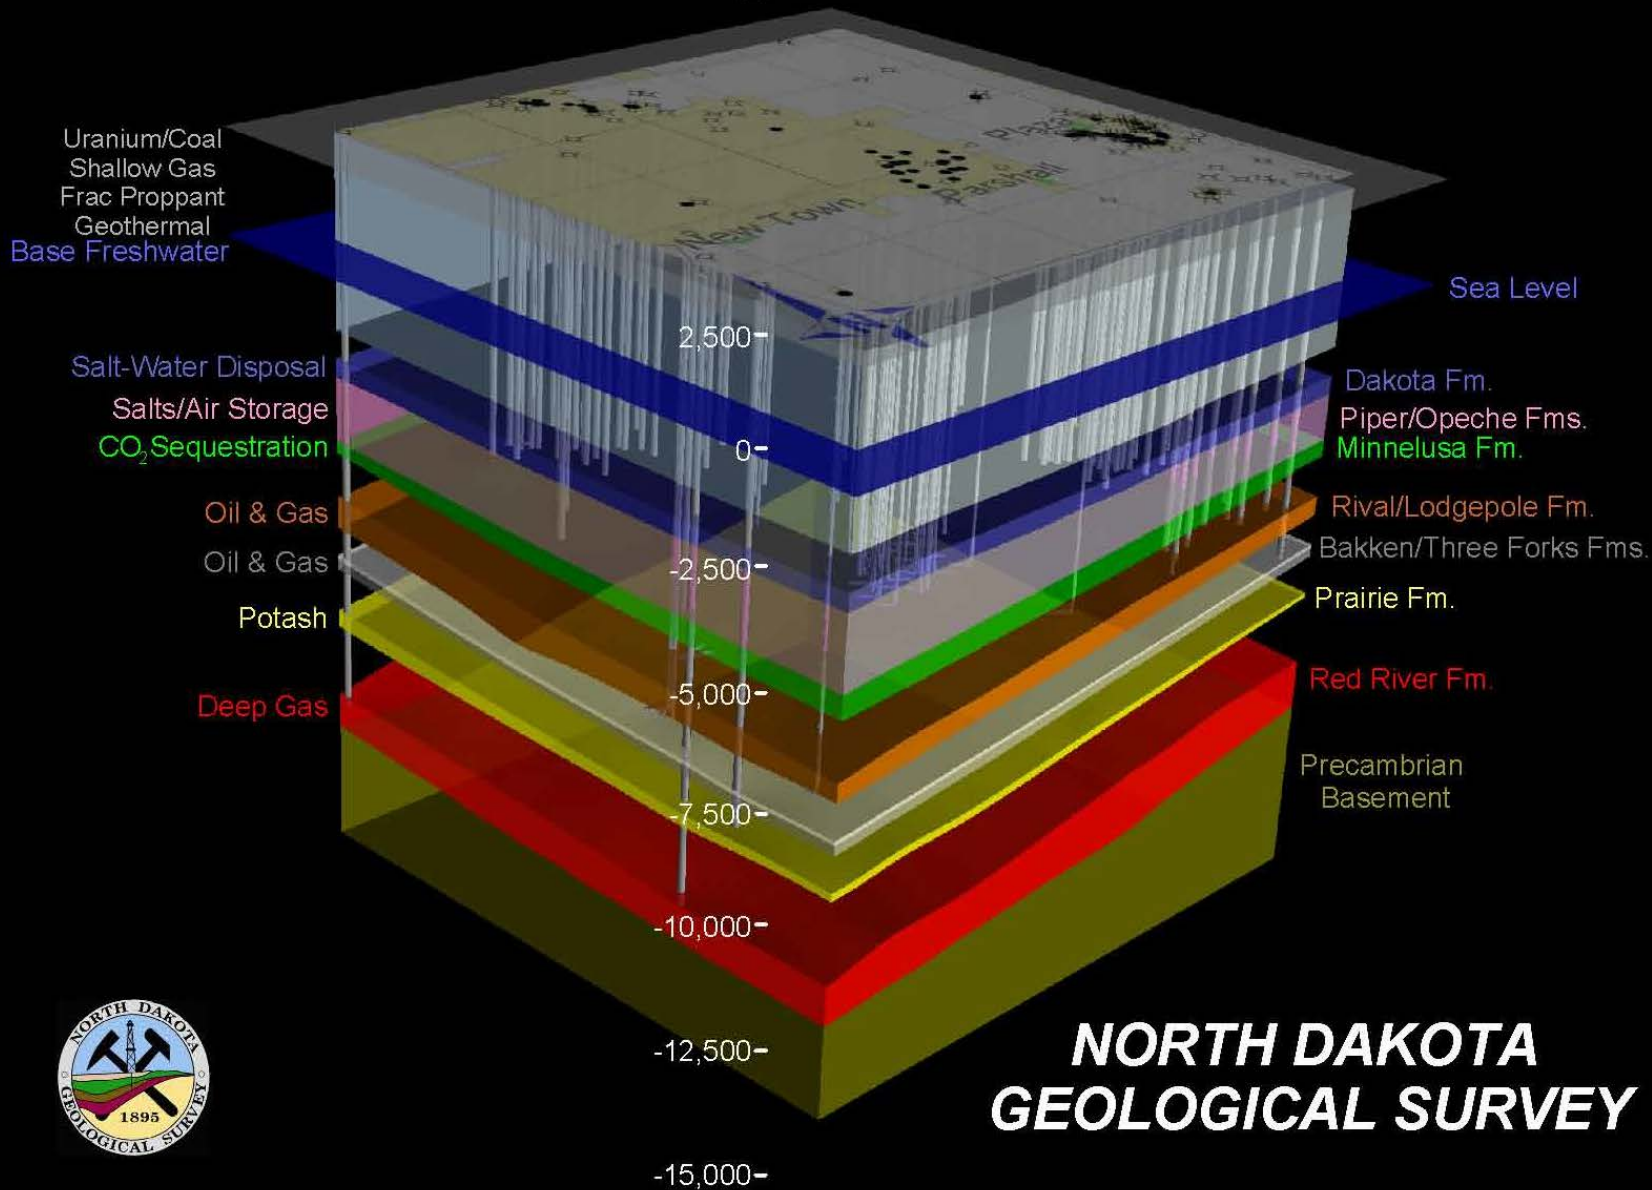


**North Dakota has been
regulating the full life cycle of
hydraulic fracturing for decades**

- **Water Comm—water withdrawals**
- **Industrial Comm—well permitting &
disposal of flowback water**
- **Health Dept—spill cleanup**

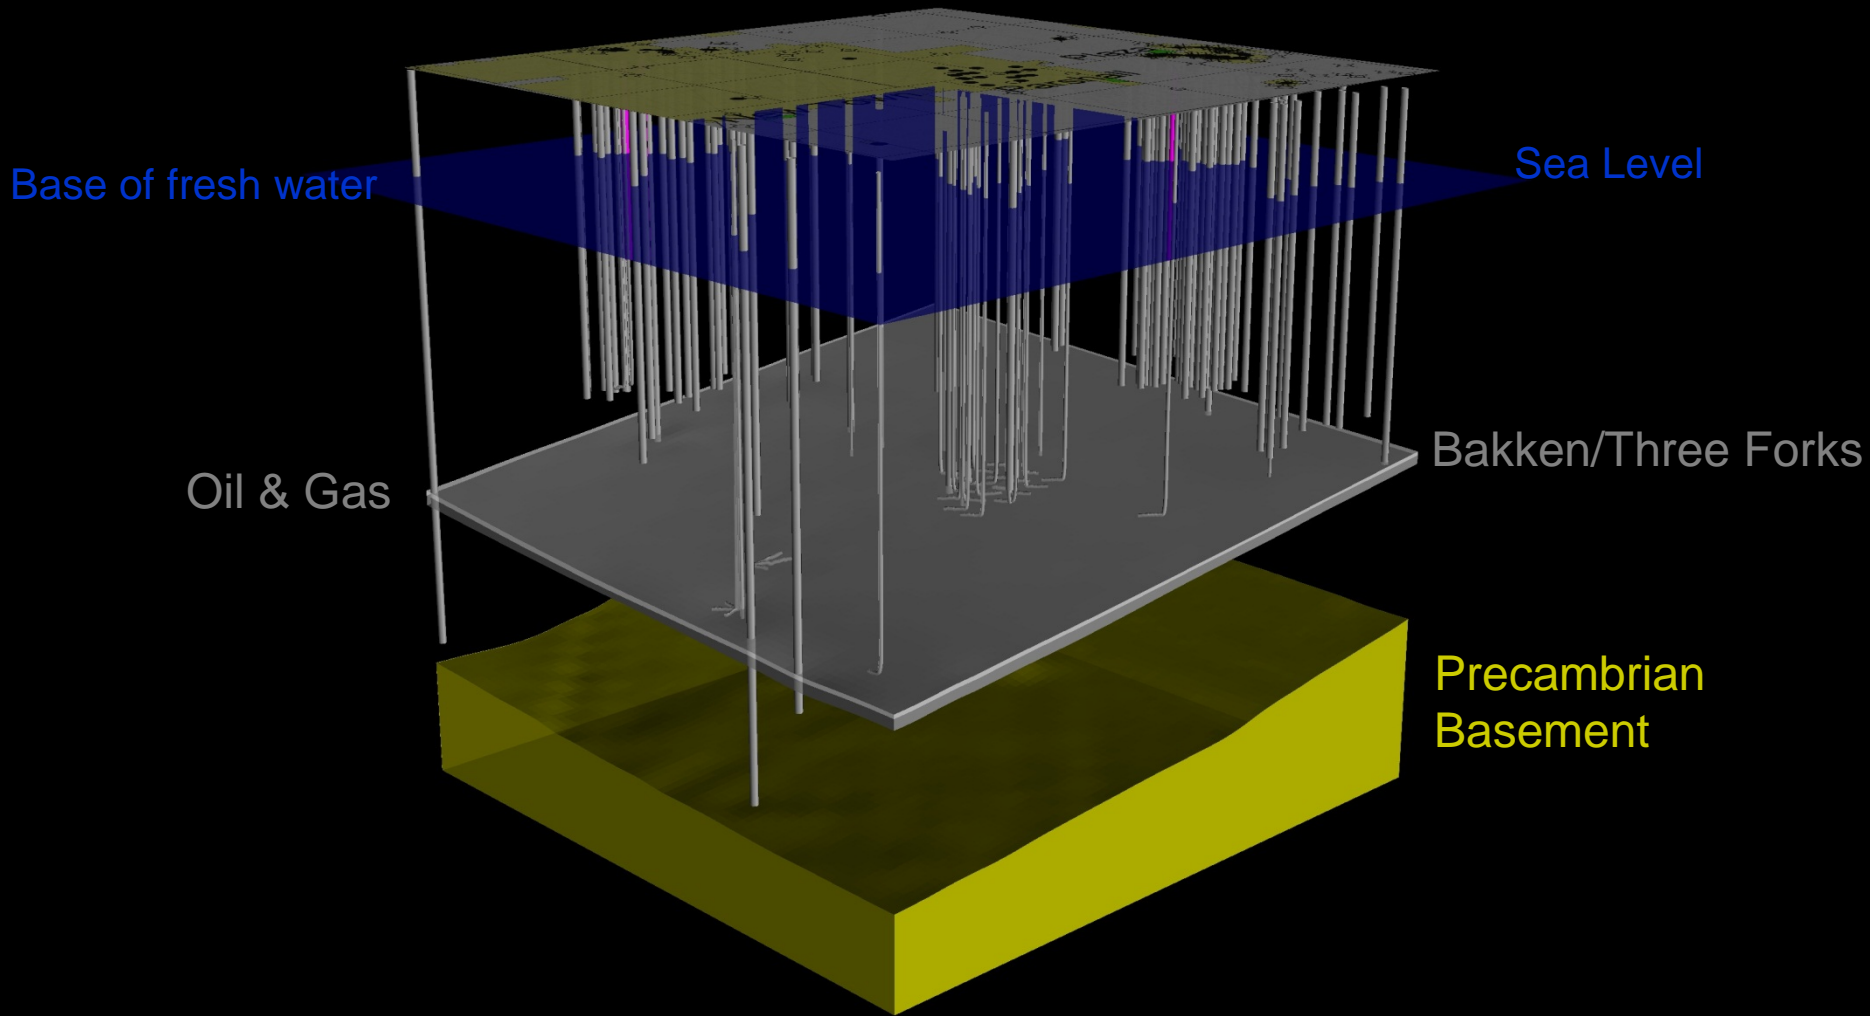

Industrial Commission Regulation

- **Water flowback after frack**
 - **Storage in open pits prohibited**
 - **Disposal wells permitted through
Underground Injection Program**
 - **Disposal zone is 2,500 feet below
potable waters**

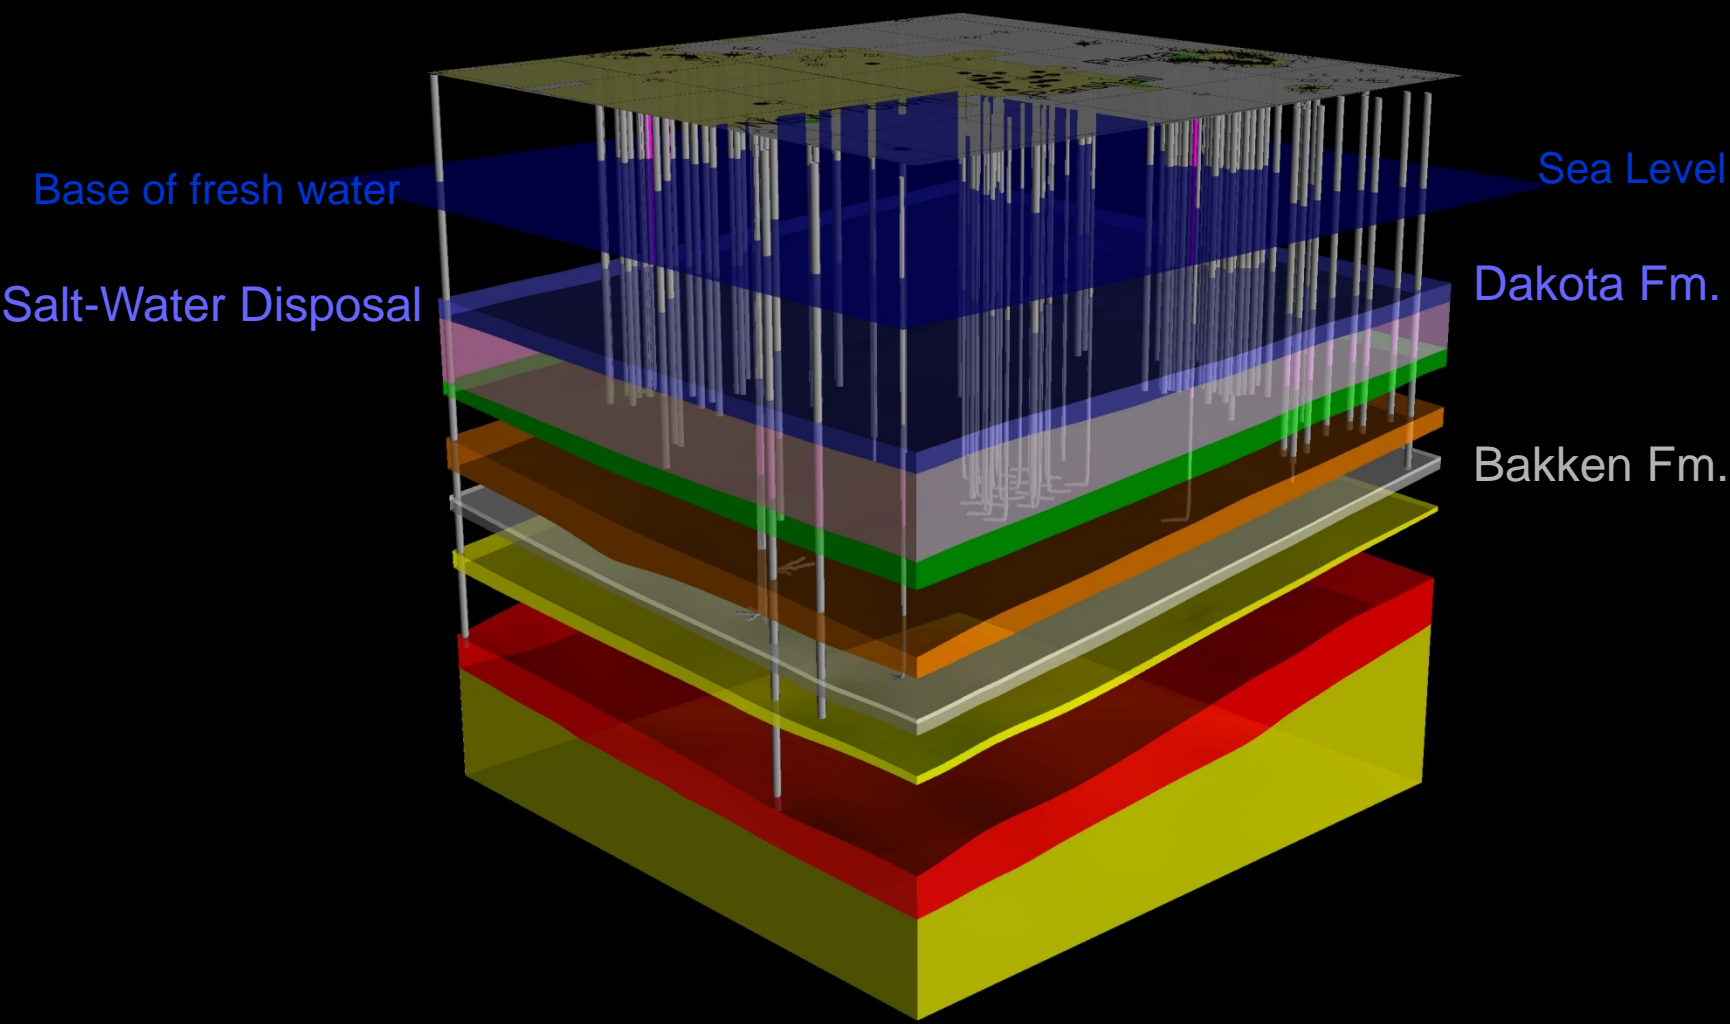

Base of fresh water

Sea Level

Salt-Water Disposal

Dakota Fm.

Bakken Fm.


FRAC WATER NEEDS

- **Lake Sakakawea best water resource**
 - **one inch contains 10 billion gal water**
 - **5000 wells @ 2mil gal wtr/well**
 - **2-year supply**

FRAC WATER ADDITIVES

- **99.5% water and sand**
 - **80.5% water**
 - **19.0% proppant**
 - **0.5% chemicals**
 - **most are found in every household**

NORTH DAKOTA – 54 DRILLING RIGS – Oct 2009

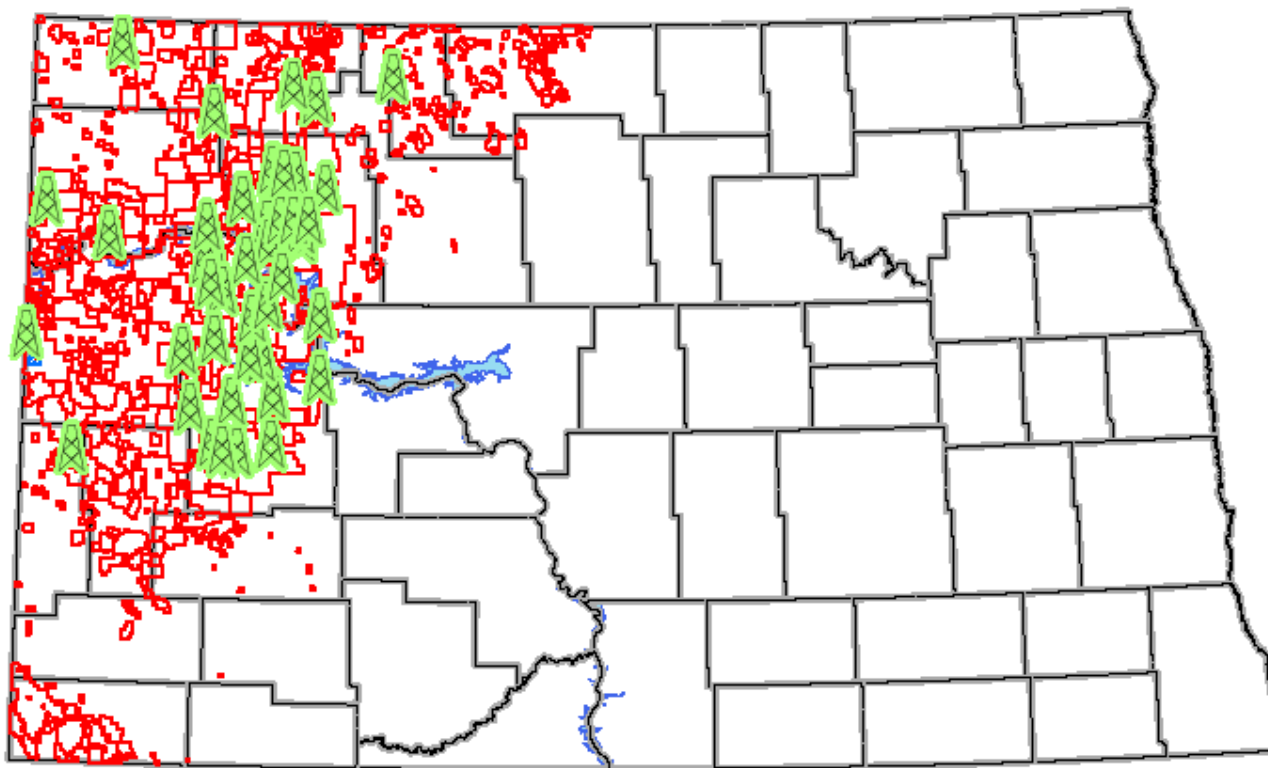


Disclaimer: Neither the State of North Dakota, nor any agency, officer, or employee of the State of North Dakota warrants the accuracy or reliability of this product and shall not be held responsible for any losses caused by reliance on this product. Portions of the information may be incorrect or out of date. Any person or entity that relies on any information obtained from this product does so at his or her own risk.

0 30 60 120 Miles

Prepared by N.D.I.C.
Oil and Gas Division



NORTH DAKOTA – 153 DRILLING RIGS – Oct 2010

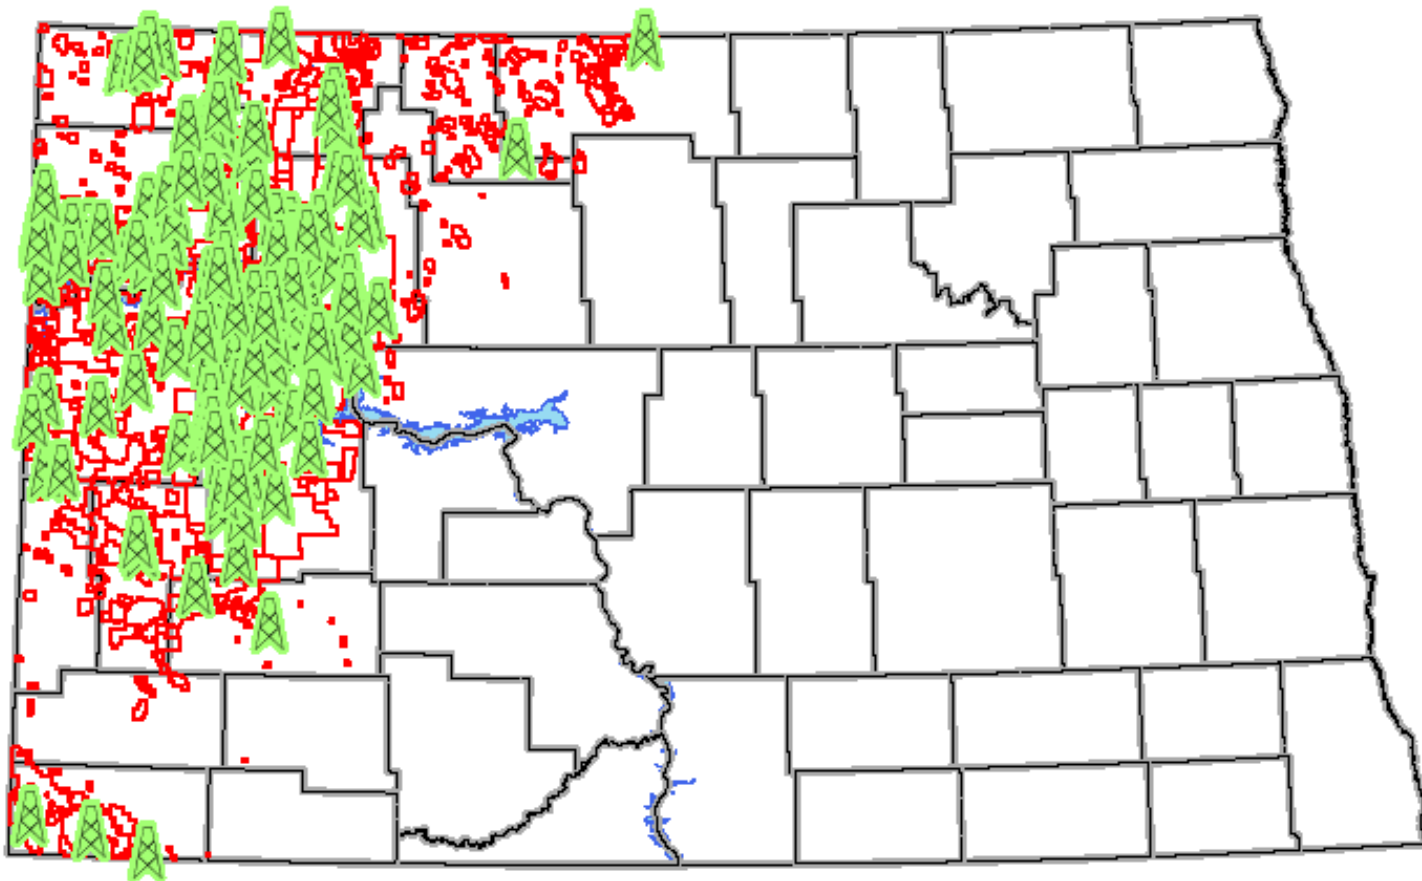


Disclaimer: Neither the State of North Dakota, nor any agency, officer, or employee of the State of North Dakota warrants the accuracy or reliability of this product and shall not be held responsible for any losses caused by reliance on this product. Portions of the information may be incorrect or out of date. Any person or entity that relies on any information obtained from this product does so at his or her own risk.

0 30 60 120 Miles


Prepared by N.D.I.C.
Oil and Gas Division
DATE : 9/17/2010
Time : 3:42:13 PM




NORTH DAKOTA – 200 DRILLING RIGS – JANUARY 2012

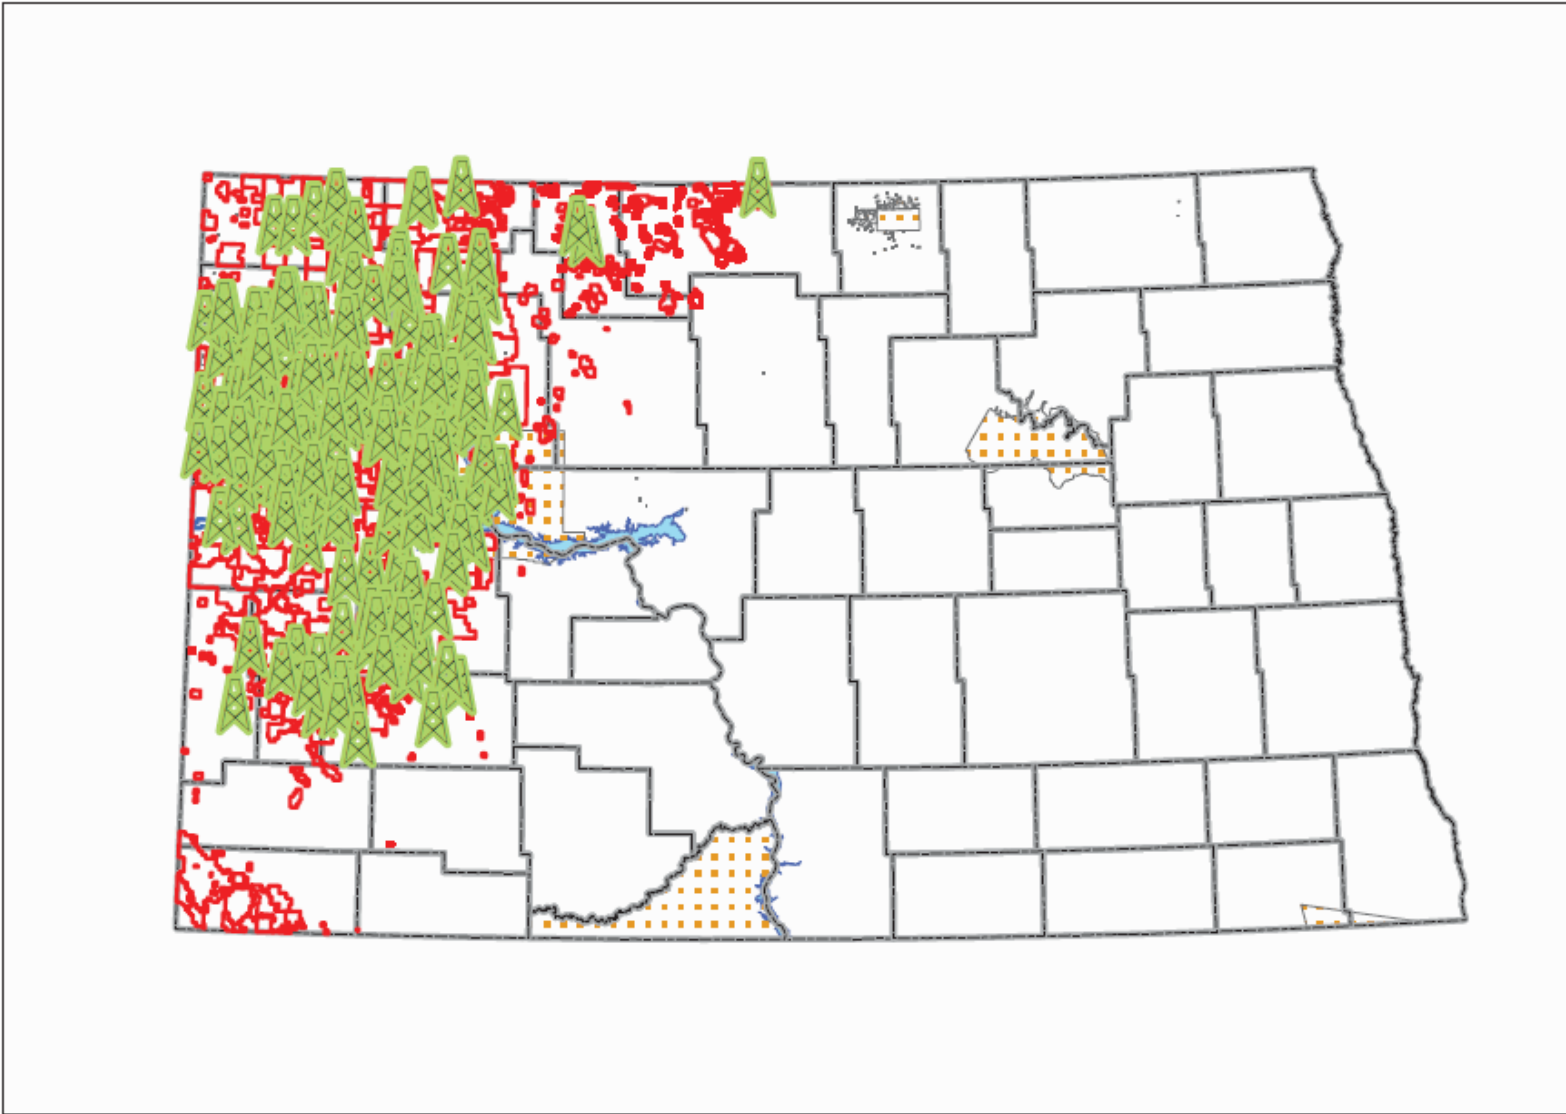

Disclaimer: Neither the State of North Dakota, nor any agency, officer, or employee of the State of North Dakota warrants the accuracy or reliability of this product and shall not be held responsible for any losses caused by reliance on this product. Portions of the information may be incorrect or out of date. Any person or entity that relies on any information obtained from this product does so at his or her own risk.

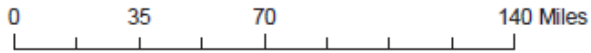


Prepared by N.D.I.C.
Oil and Gas Division
DATE : 1/13/2012
Time : 7:53:24 AM

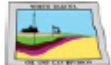


Regionally Extensive

Area covered by Bakken source rocks in North Dakota

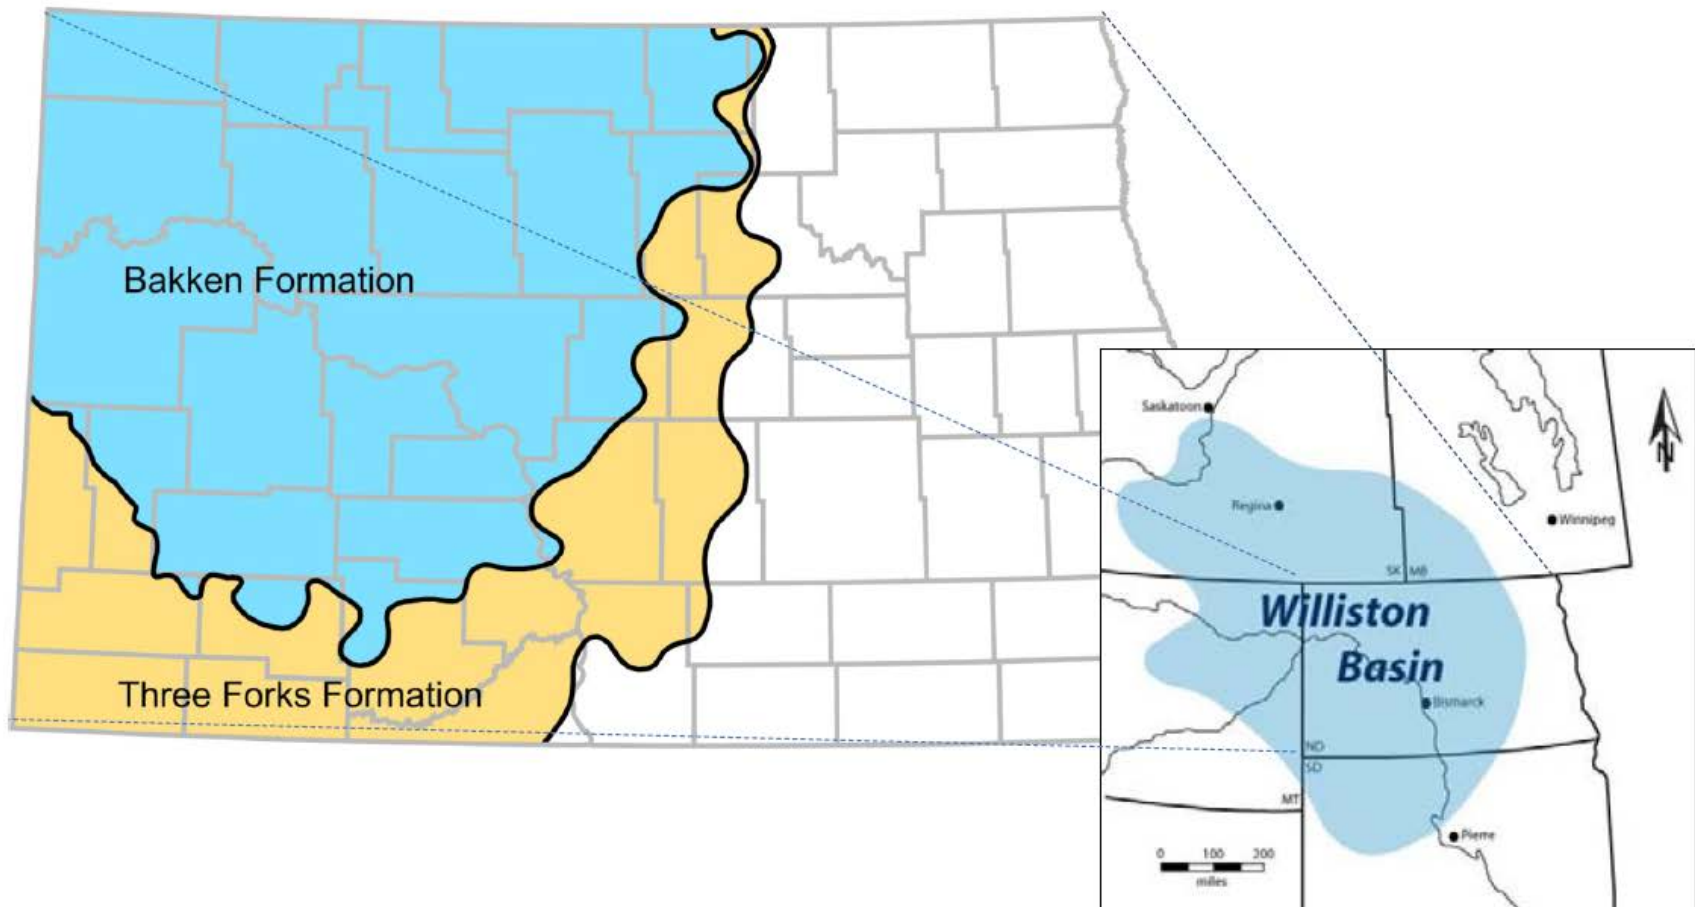


ESTIMATED MATURE AREA OF THE BAKKEN FORMATION

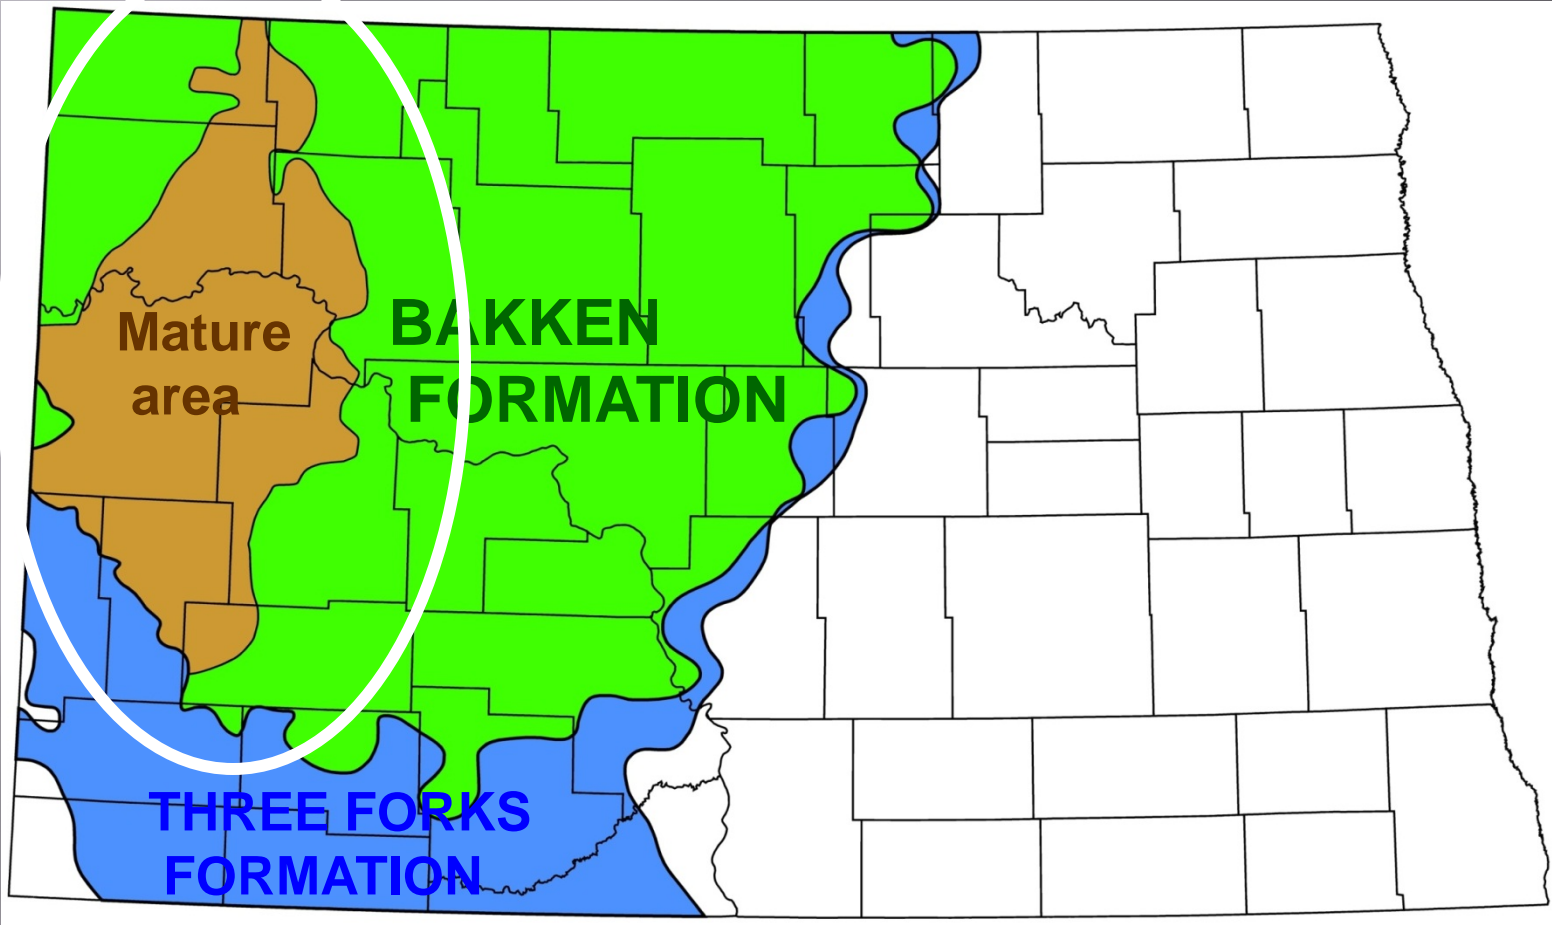

(Nordeng, 2010)




North Dakota Well Depth and % Horizontal

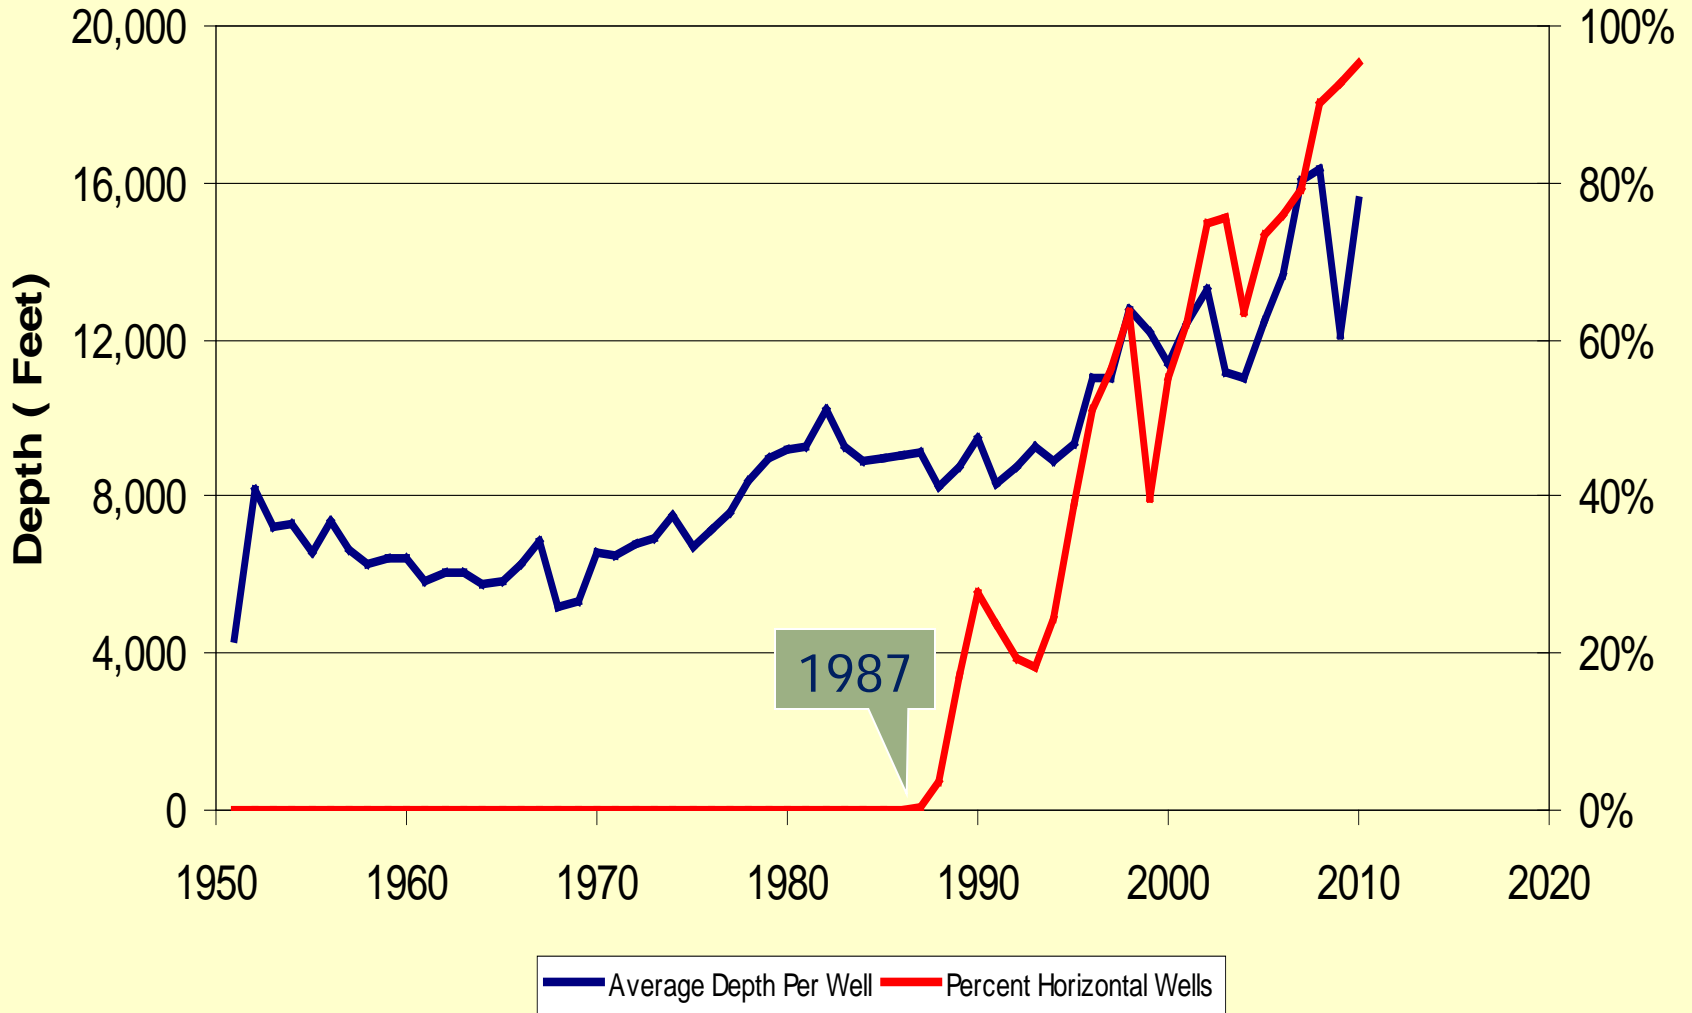




United States Daily Oil Production -- March 2011

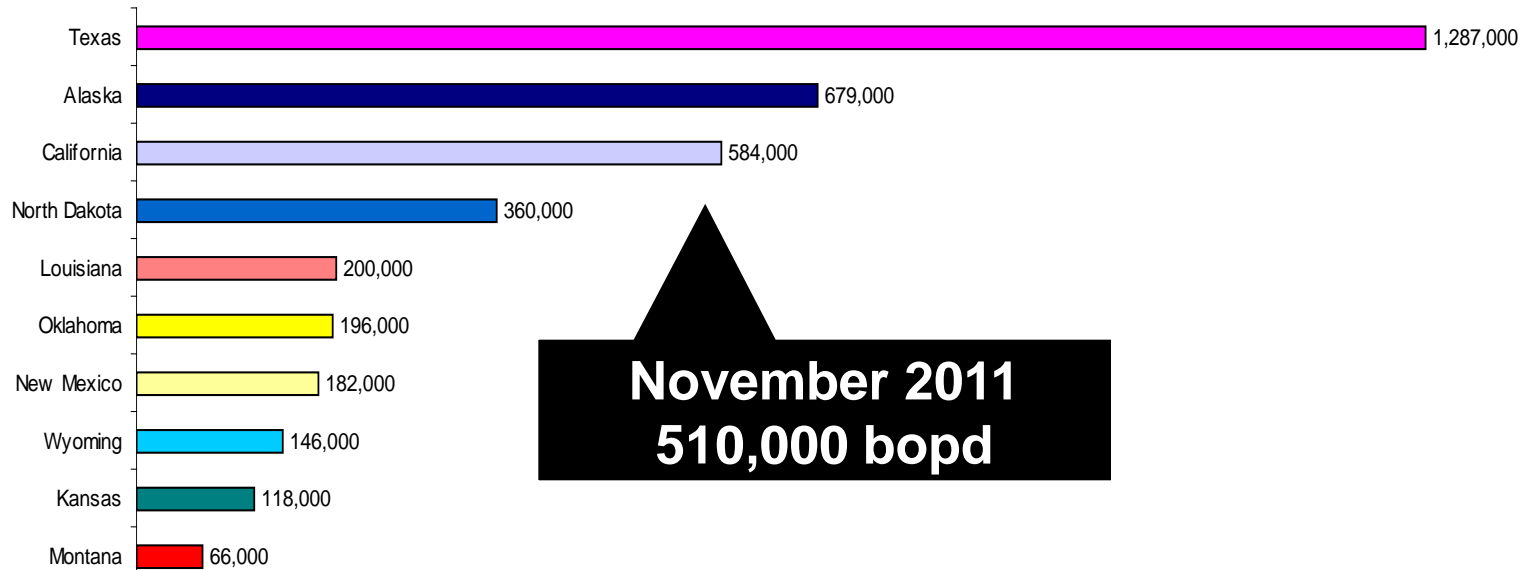

**November 2011
510,000 bopd**

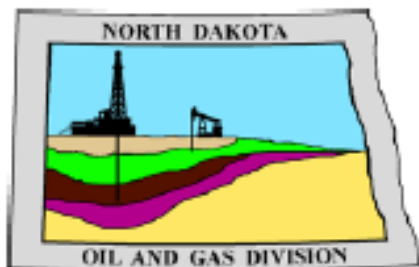

Oil and Gas Division

Lynn D. Helms - Director Bruce E. Hicks - Assistant Director

Department of Mineral Resources

Lynn D. Helms - Director

North Dakota Industrial Commission

www.dmr.nd.gov/oilgas/

For Immediate Release

January 10th, 2012

Contact Alison Ritter 328-8036

North Dakota Surpasses Half a Million Barrels of Oil per Day

BISMARCK- North Dakota has reached a milestone in oil production. Preliminary November data released today, indicates that North Dakota is now producing more than half a million barrels of oil per day, at approximately 510,000 barrels. That's an increase of about 22,000 barrels from October and an increase of more than 150,000 barrels a day from one year ago.


"Oil production in the state has increased anywhere from 8,000 to 40,000 barrels a day, every month since June," says Oil and Gas Division Director Lynn Helms.

Recent data from California, the number three oil-producing state in the country, is producing about 570,000 barrels a day.


Production numbers for November show North Dakota producing nearly 15.3 million barrels for the month, as well as having 6,300 producing wells.

"This is big news for the state and the country. A half a million barrels a day represents about 10 percent of U.S. production. That's enough oil to displace imports from Iraq or Columbia," Helms said.


Data for December will not be released until February.

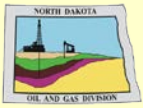


North Dakota Wells Producing Each Year

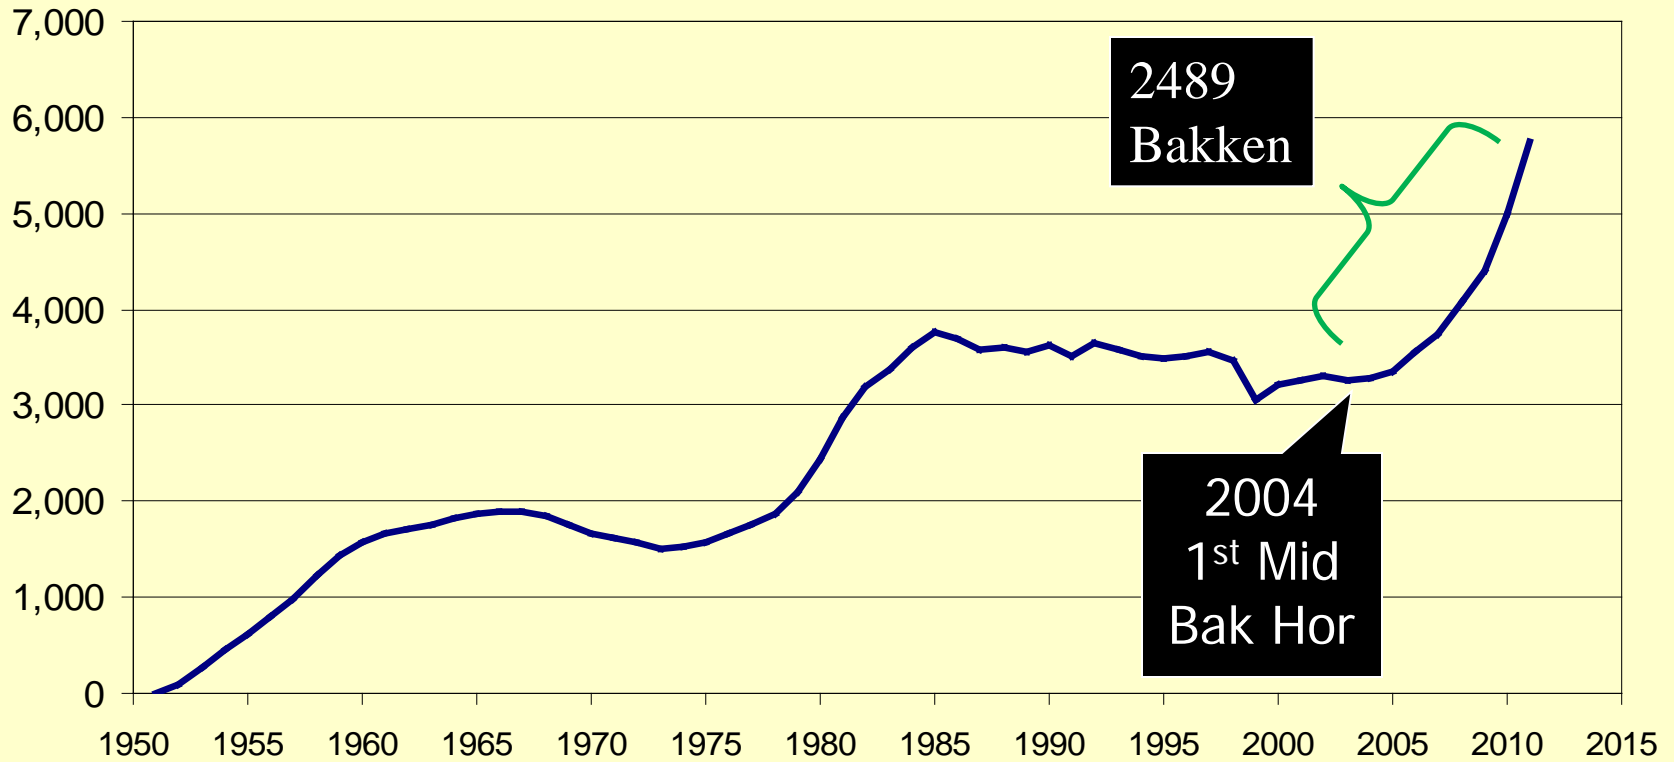

5756 total wells – 2489 Bakken horizontal (43.2%)

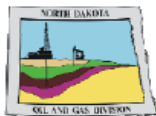



North Dakota Daily Oil Produced and Price

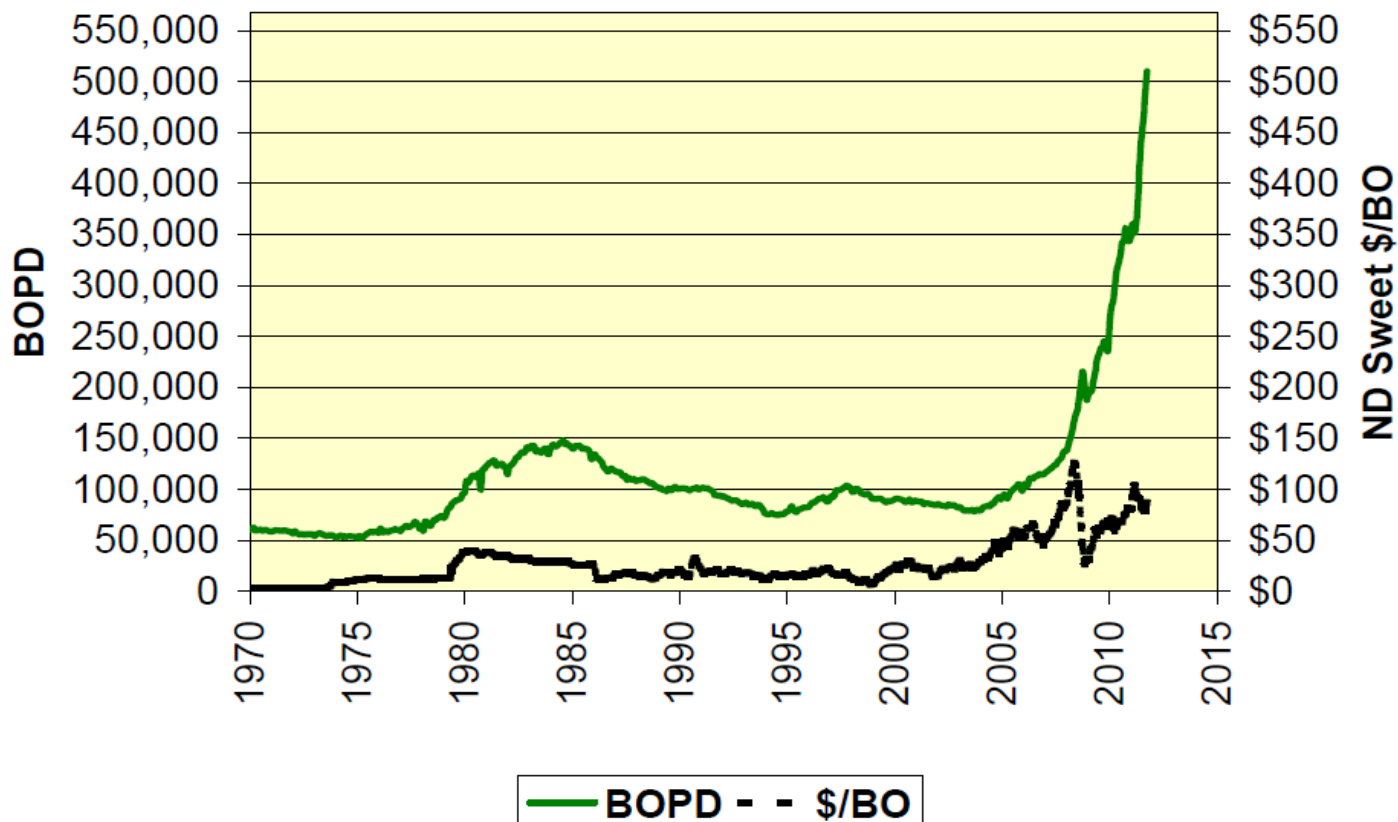




North Dakota Monthly Production Top 12 Counties

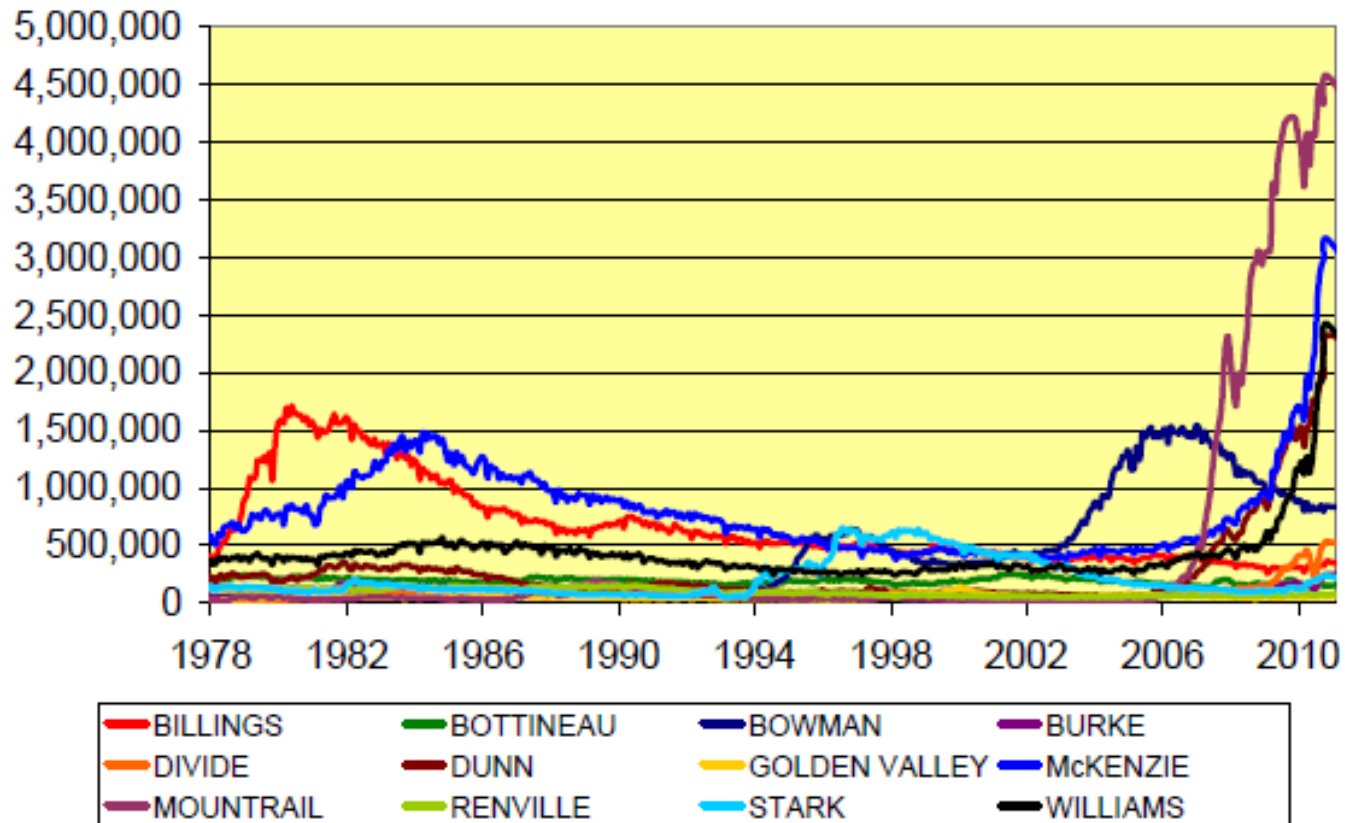

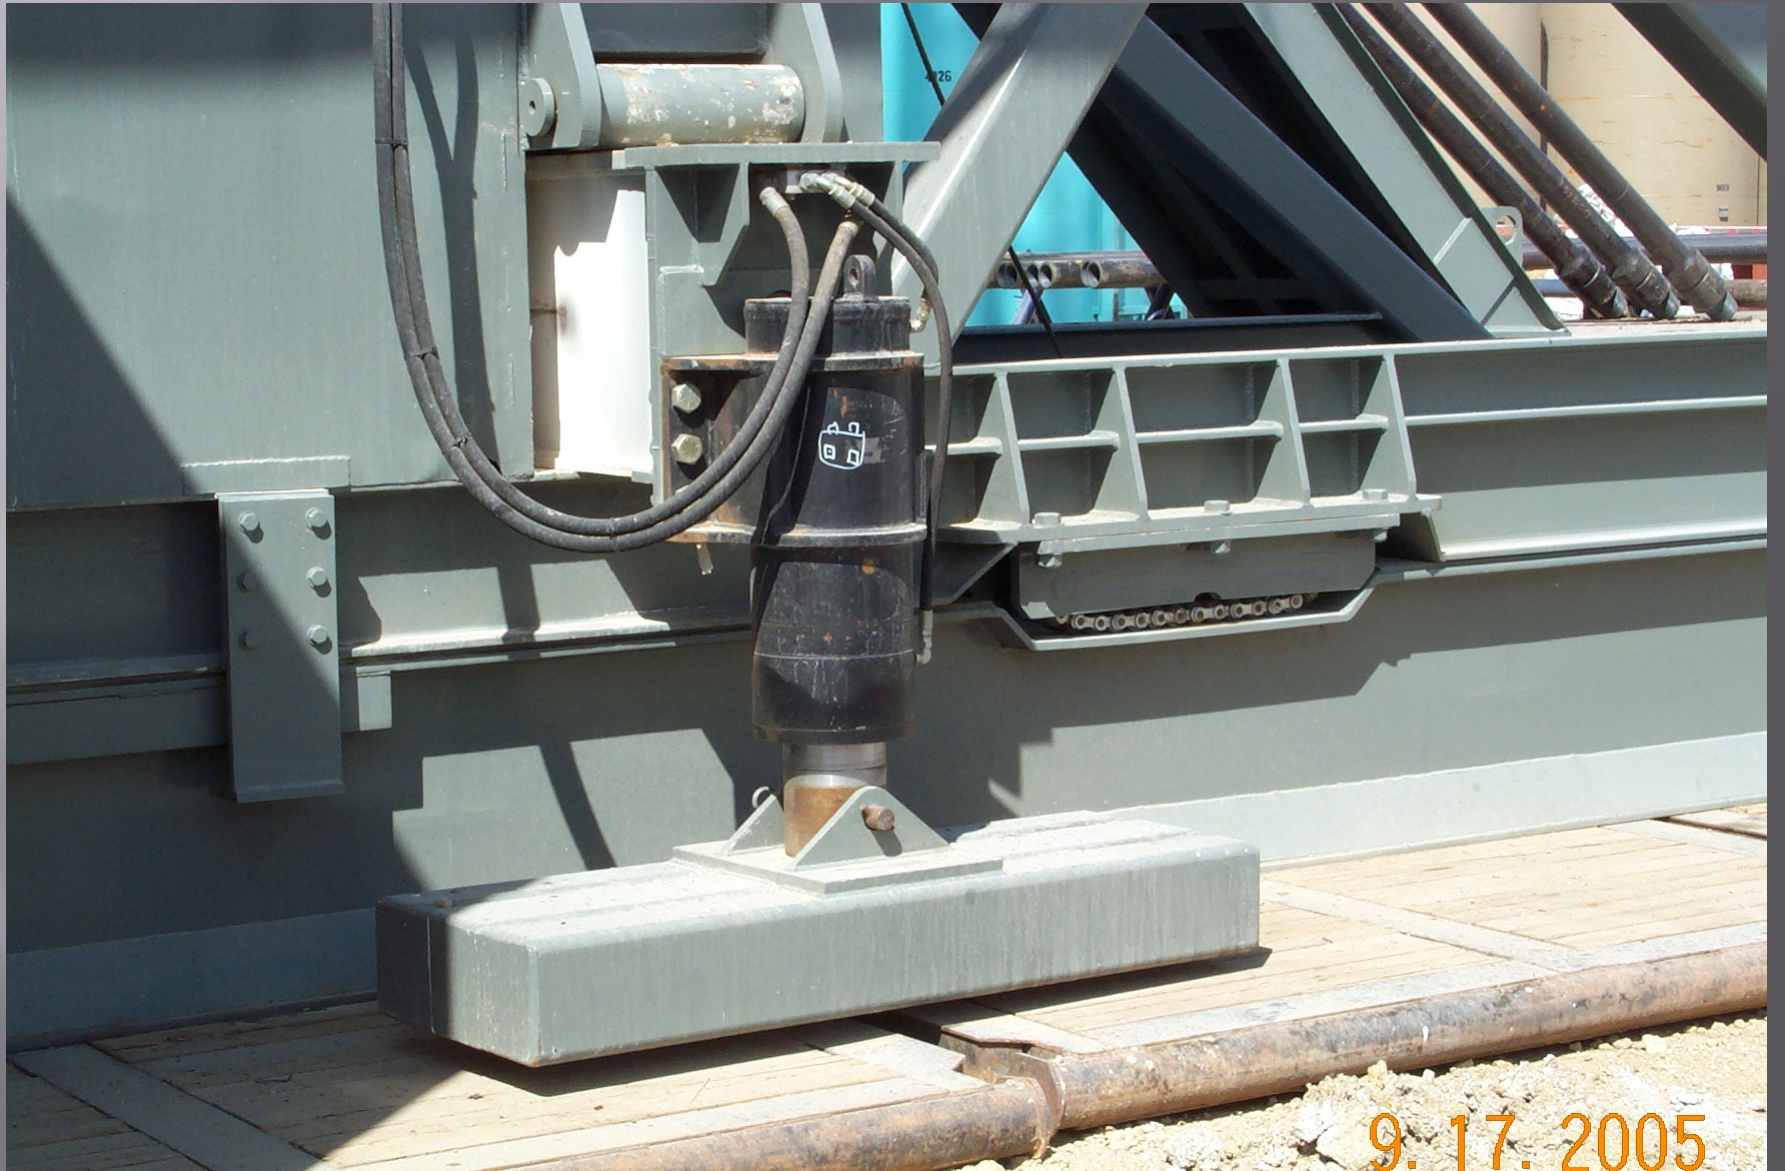

9.17.2005

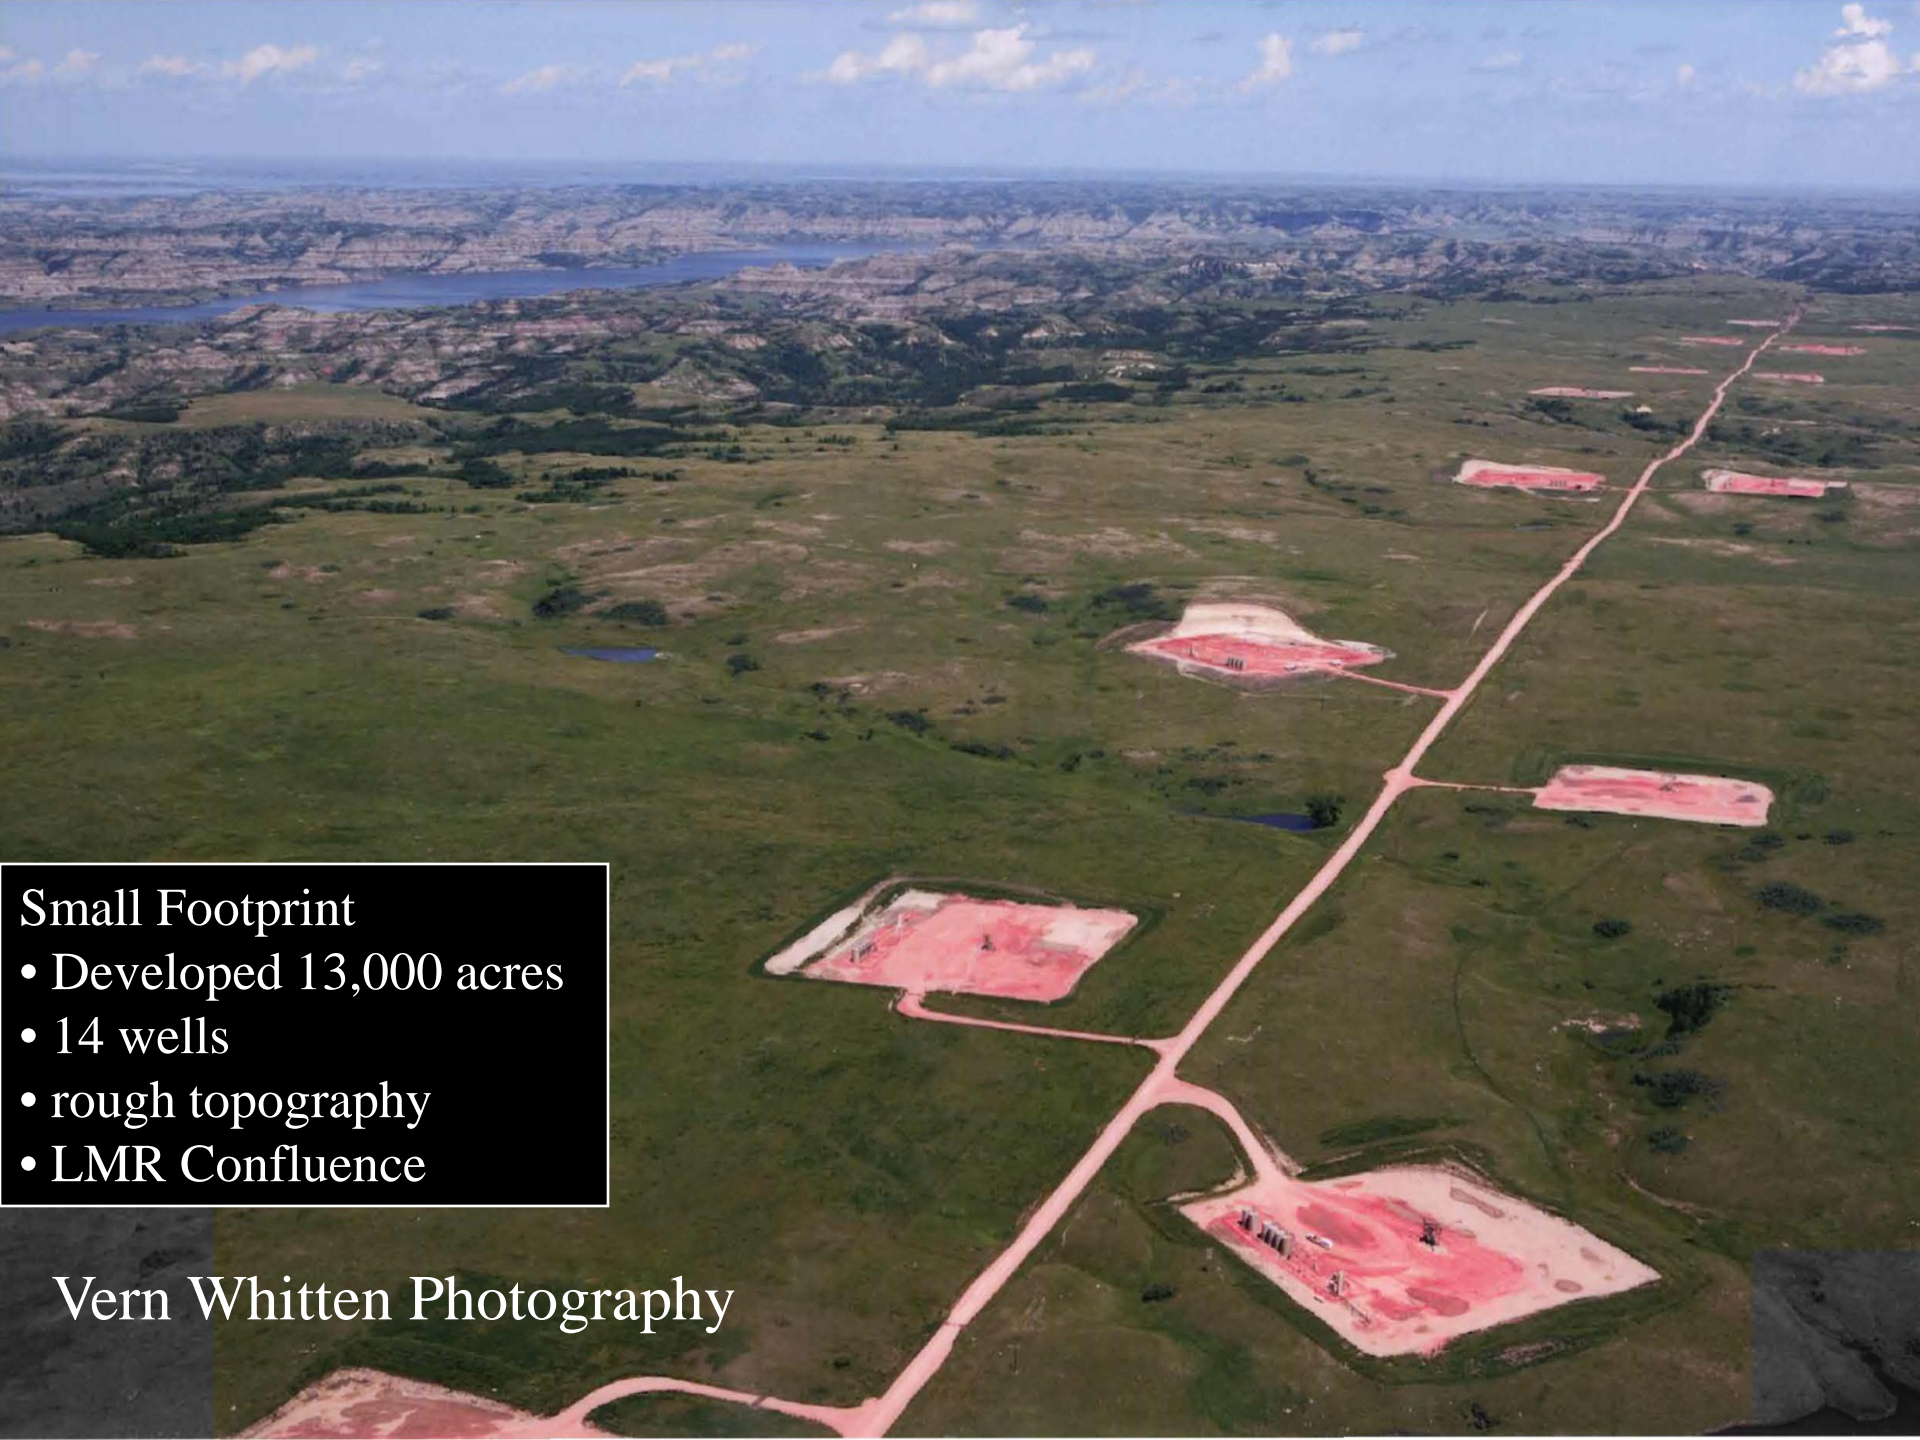


Small Footprint

- Developed 13,000 acres
- 14 wells
- rough topography
- LMR Confluence

Vern Whitten Photography

- Full Map
- View Entire State
- Previous View
- Clear Selection
- Search
- Generate PDF
- Zoom In
- Zoom Out
- Pan
- Rect Identify
- Select Object
- Buffer
- Distance
- Find Well
- Find Field/Unit
- Find Section

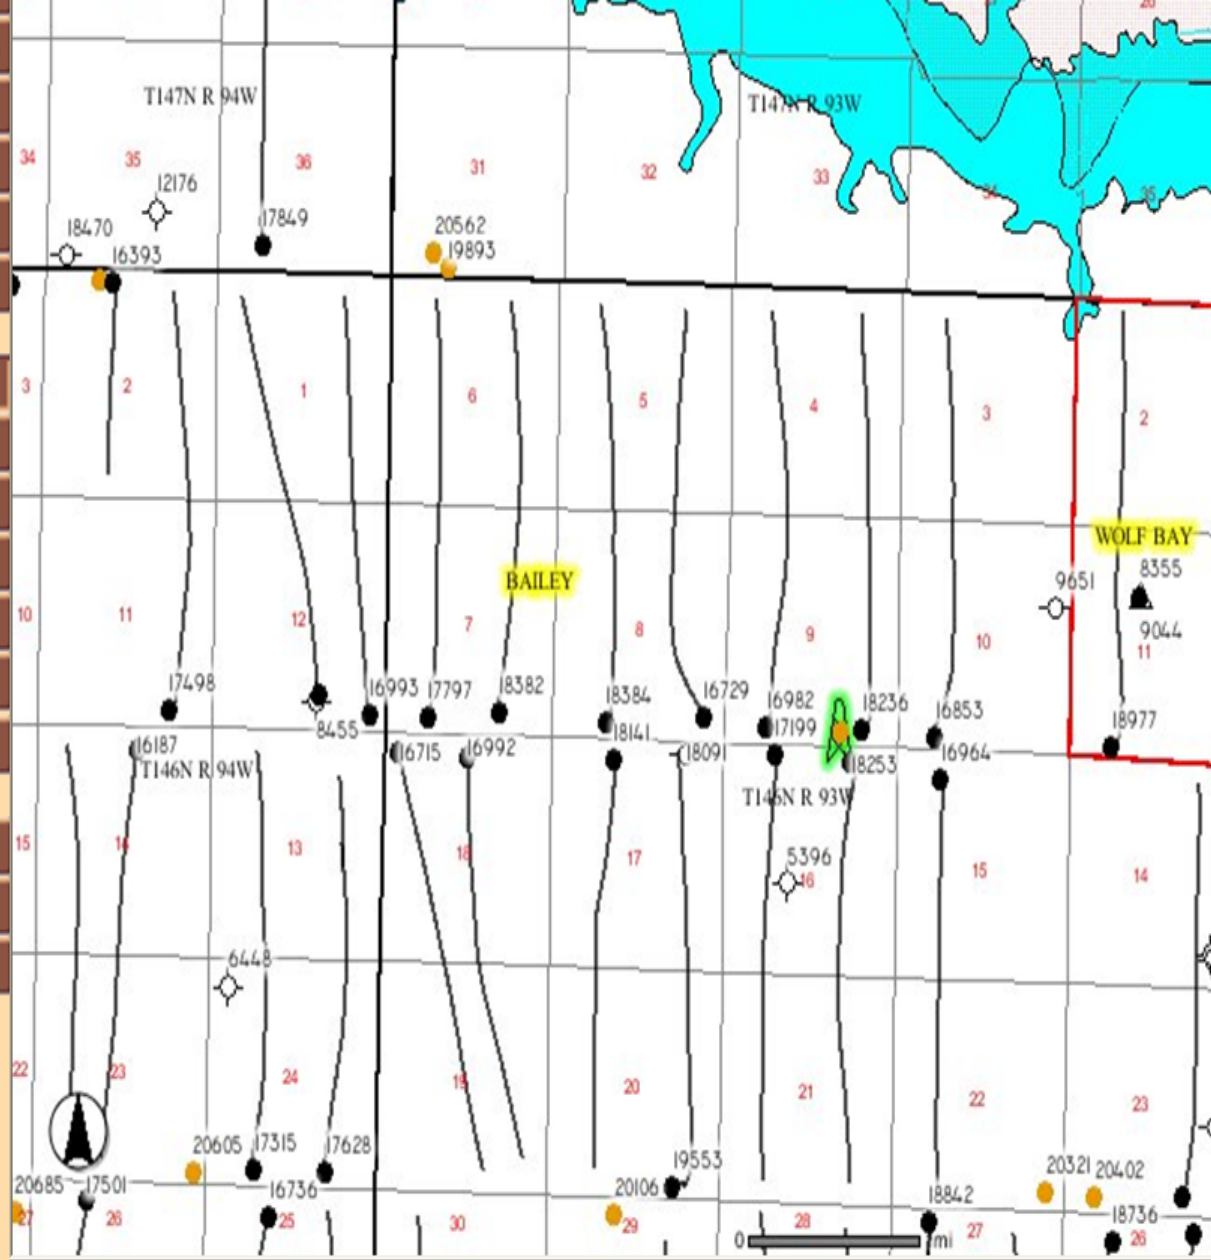

- Wells
- Rig Location
- Directional Surveys
- Directional Legs
- Horizontal Surveys
- Horizontal Legs
- Cases Docketed
- Oil Fields
- Unit Boundaries
- Inspector Areas
- Drilling / Spacing
- Seismic
- Gas Plants
- Other
- Reservations
- Corporate Boundaries
- Rivers and Roads
- County Roads
- Major Roads
- Major Rivers
- Missouri River
- Land Ownership
- Imagery
 - Topo/DRG 250k
 - Topo/DRG 100k
 - NAIP 2009


Refresh Map

Auto Refresh

Major Rivers
Selection cleared.

- Help:
- A closed group, click to open.
 - An open group, click to close.
 - A map layer.
 - A hidden group/layer, click to make visible.

North Dakota Natural Gas Pipelines

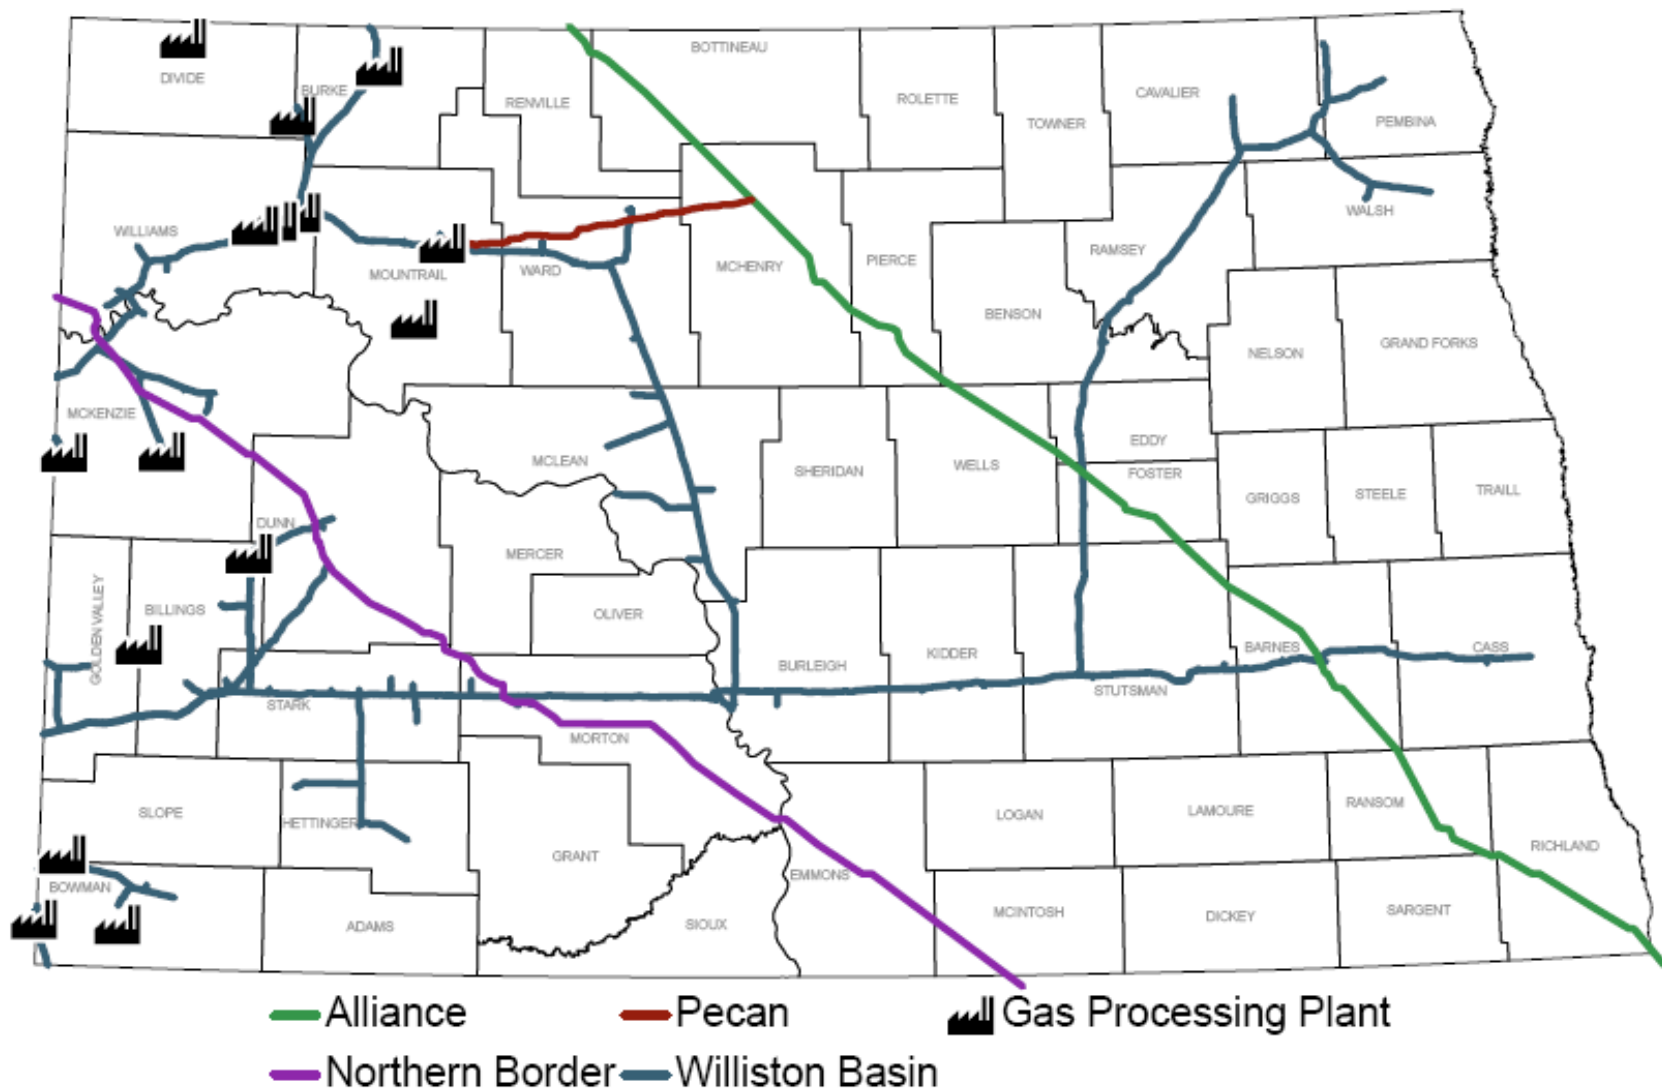

Stateline I Gas Plant
(Bear Paw)
100 MMCFPD
3Q 2011


Stateline II Gas Plant
(Bear Paw)
100 MMCFPD
2Q 2013

Glass Bluff Gas Plant
(Hiland)
50 MMCFPD
Sep 2011


Little Missouri Gas Plant
(Saddle Butte)
5 MMCFPD--LPG
Operational

Garden Creek Gas Plant
(Bear Paw)
100 MMCFPD
4Q 2011

Belfield Gas Plant
(Whiting)
100 MMCFPD
4Q 2011

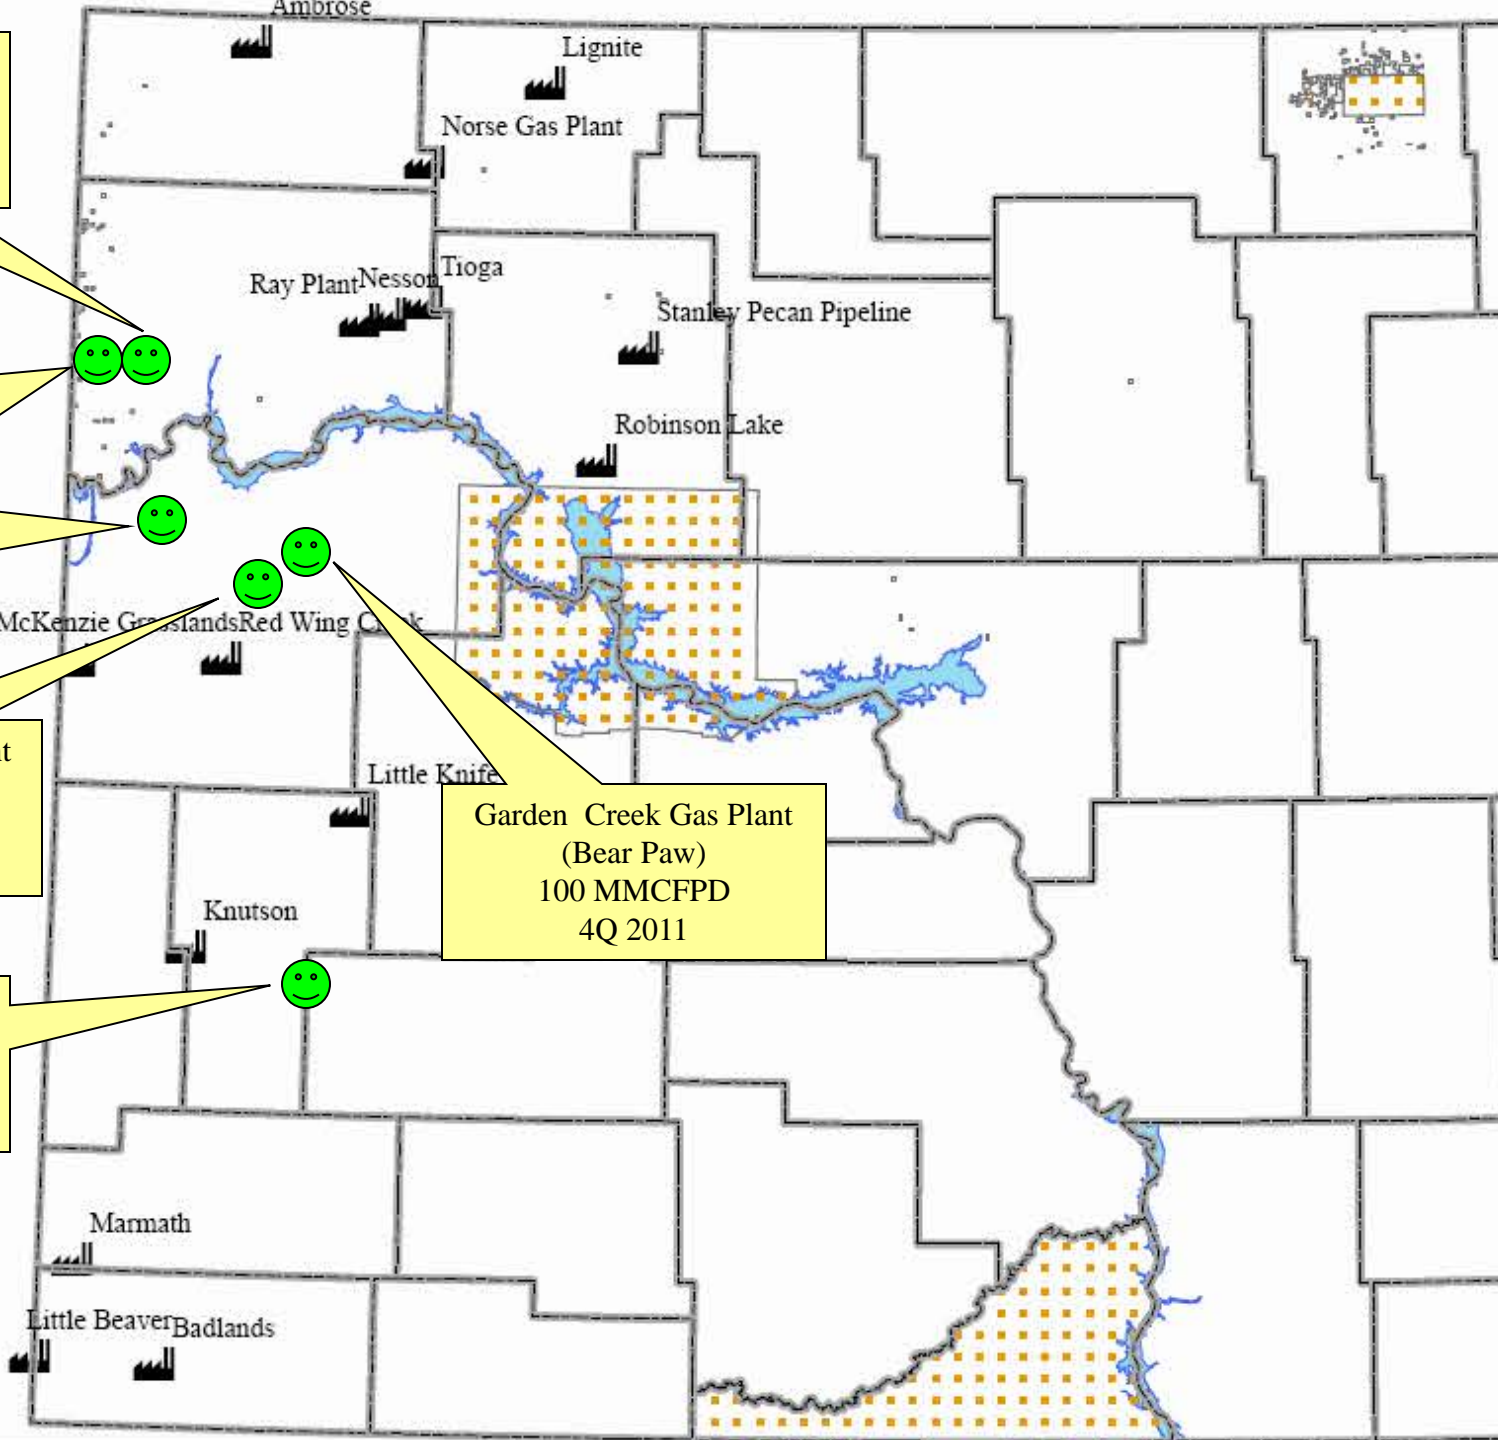

North Dakota Monthly Gas Flared

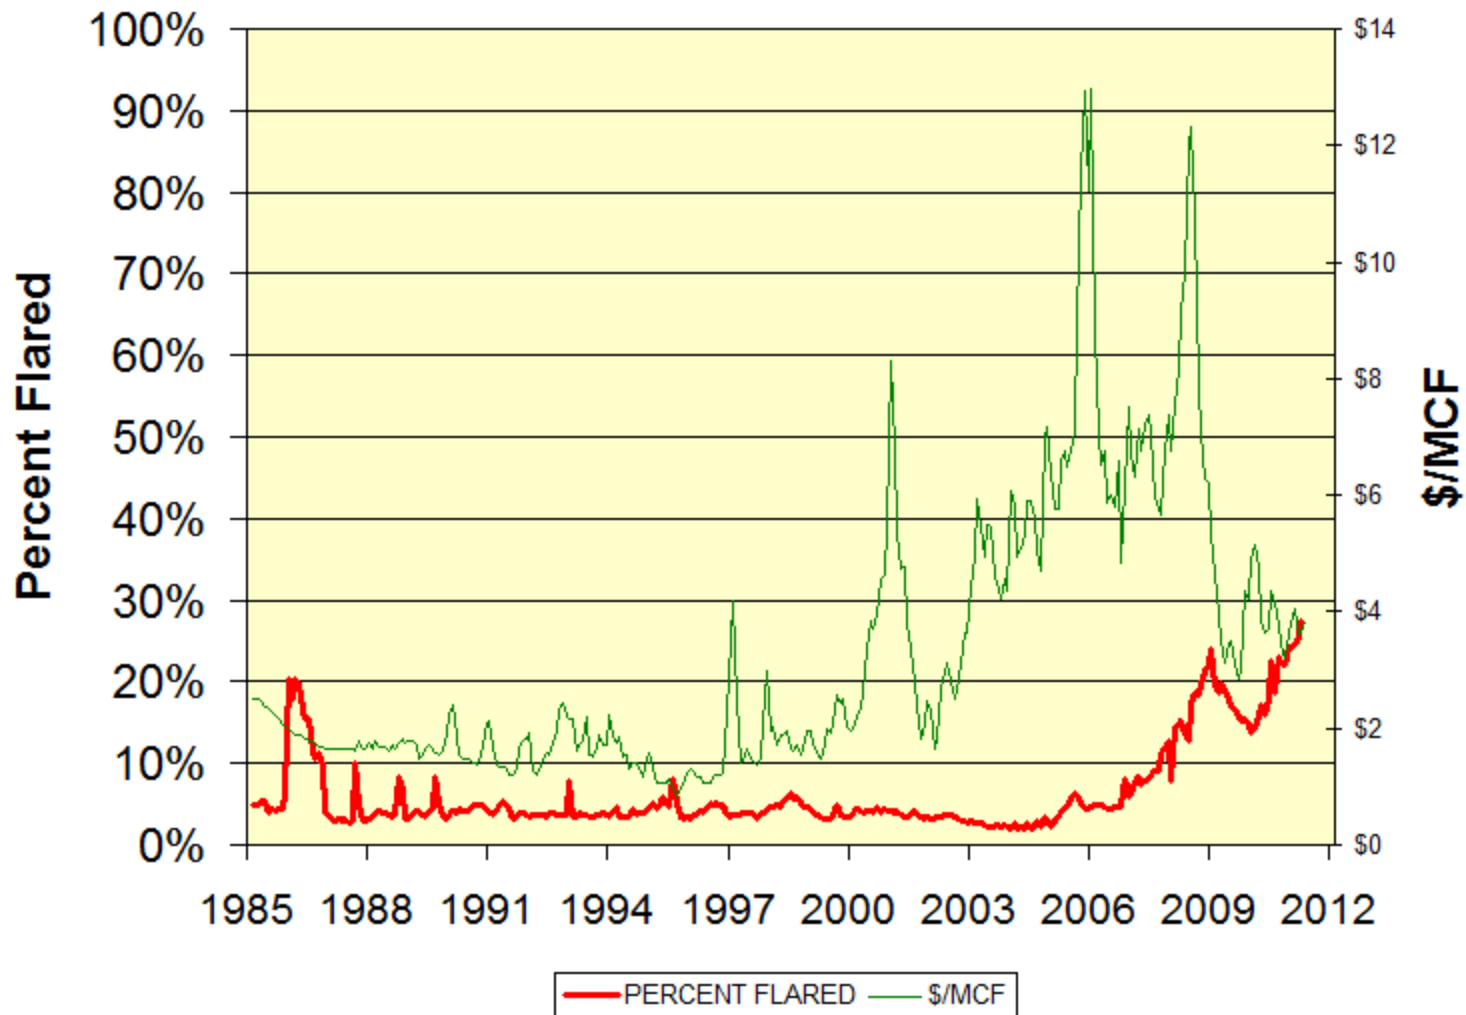



Performing hydraulic fracture stimulation south of Tioga

- all Bakken wells must be hydraulically fractured to produce
- > 2 million gallons of water
- > 3 million pounds of sand
- cost > \$2 million

BAKKEN PROVIDES ENERGY/JOBS

- 5,000 wells in next 2 yrs
 - will double our cur wells @ cur rigs
 - all require hydraulic stimulation
 - provides significant domestic energy
 - creates numerous jobs

Job Opportunities

- 170 – 225 rigs
 - 20,000 jobs in drilling
- 15 – 25 years
 - 28,000 additional wells
 - 28,000 long term jobs

NDSU Economic Impact Study

- **Calendar Year 2009 Impact Study**
 - \$5 billion direct impact
 - \$13 billion secondary impact
 - \$822 million taxes
 - 18,328 direct jobs
 - 52 rigs + \$52.35/bo
- **Calendar Year 2010 Impact Study**
 - 126 rigs + \$69.74/bo

BAKKEN FORMATION

■ NDIC-DMR estimated

- appr 200-300 billion bo in place in ND
- 34-yr supply @ current US consumption
 - 2.1 billion bo recovery in ND w/1well
 - 4.2 billion bo recovery in ND w/2wells
 - 1-7 horizontal wells / spacing unit

USGS estimated (independent simultaneous study)

- 2.6 billion bo recovery in ND
- largest continuous resource they have assessed in lower 48 States






THREE FORKS FORMATION

NDIC-DMR estimated

- **1.9 billion bo recovery in ND w/1well**
- **3.8 billion bo recovery in ND w/2wells**

USGS: (No study)

BAKKEN POOL: BAKKEN AND THREE FORKS ASSESSMENT EXPECTED ULTIMATE RECOVERY

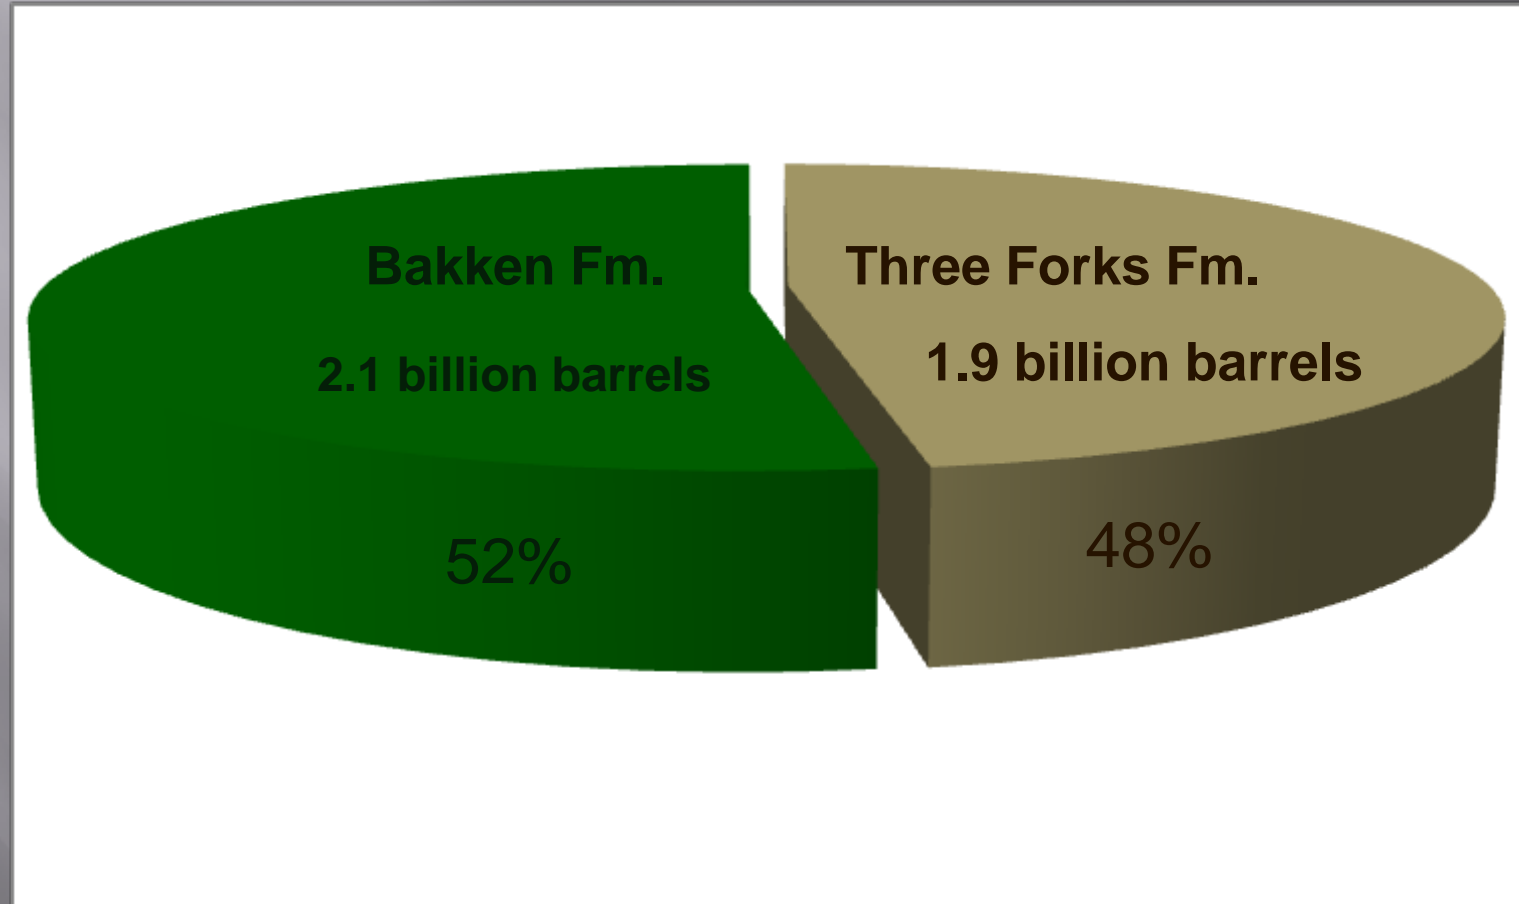

(Nordeng and Helms, 2010)


NDIC PERMITTING.

E-Permit info links on NDIC website

North Dakota nd.gov Official Portal for North Dakota State Government

Services

- Rules & Regulations
- Forms
- Hearing Dockets
- Active Drilling Rigs
- Daily Activity Reports
- Confidential Well List
- General Statistics
- Seismic
- Well Search
- Report a Spill/Incident
- GIS Map Server
- Publications
- Surface-Mineral Owner
- Basic Services
- Premium Services
- Electronic Filing**
- Related Links
- FAQ / Web Help
- Contact Us
- Employee Directory
- E-Mail Addresses



WELCOME TO THE NORTH DAKOTA INDUSTRIAL COMMISSION, DEPARTMENT OF MINERAL RESOURCES, OIL AND GAS DIVISION, HOME PAGE.

Director's Cut - 09/14/2010 and Recent Presentations

The Director's Cut is an update on current activity in the North Dakota oil patch from the Director of the Department of Mineral Resources. ([View past Director's Cuts](#))

Please **TAKE ACTION NOW** to tell the EPA you support increased oil and natural gas production—and the use of hydraulic fracturing: a time-tested, safe process that helps us access more of our own reserves!

Three Forks Assessment CD
Call 328-8000 to order the 2010 Three Forks Assessment CD for \$50.00!

North Dakota nd.gov Official Portal for North Dakota State Government

Oil and Gas Division eFile

Online Permitting

Before you can file permits online, you must fill out and return to our office, an [ePermit authorization form](#). Once we receive the completed form, we will issue you a user-id and password to access the online permitting system. You may then log into the ePermit system using the link below.

[File permits online.](#)

Online Production and Injection Reporting

Before you can file production and injection data online, you must fill out and return to our office, an [eReport authorization form](#). Once we receive the completed form, we will issue you a user-id and password to access the online reporting system. You may then log into the eReport system using the link below.

[File forms 5, 5B, 16, 17, and 17A online.](#)

North Dakota nd.gov Official Portal for North Dakota State Government

Oil and Gas Division ePermit

Online Permitting

Please read the [instructions and system requirements](#) for filing permits online prior to using the PDF forms.

[Form 1](#) - Permit to drill a vertical or directional well.
[Form 1H](#) - Permit to drill a horizontal well.

NDIC Form 1 & 1H authorization



North Dakota Industrial Commission
Department of Mineral Resources
Oil & Gas Division

FORM 1 – 1H

E-FILING AUTHORIZATION

COMPANY: _____

This form authorizes the person(s) listed below to access the Department of Mineral Resources E-Filing URL for the purpose of submitting for approval a Form 1 and/or Form 1H Application for Permit to Drill.

A new authorization will be required if any changes are to be made to the authorized individuals on the form.

The data submitted from the e-mail address(es) listed below have been checked and conform to the standards and procedures set forth by the NDIC Department of Mineral Resources.

Authorized Individuals

E-Mail Address

Authorized Signature: _____ Date: _____

Printed Name: _____

Witness Signature: _____ Date: _____

Printed Name: _____

e-Permitting instructions

North Dakota Oil and Gas Division Form 1 and Form 1H Data Entry Procedures

- Prerequisites
 - Most current Adobe Reader – free download from Adobe.com
 - Adobe Reader Settings – Remove caching of previous entered forms data
 - Open Adobe Reader
 - Click Edit – Preferences
 - Remove the checkbox for “Keep forms data temporarily available on disk
 - Click OK to close Adobe Reader
 - Authorized UserID and Password from ND Oil and Gas
 - Internet connection – URL’s below
 - Form 1H (“<https://www.dmr.nd.gov/oilgas/webforms/wform1h.pdf>”)
 - Form 1 (<https://www.dmr.nd.gov/oilgas/webforms/wform1.pdf>)
- Procedure
 - Templates
 - You do not have to create or use templates. You can simply enter permits entirely from scratch, save them until complete, and submit them when they are done being entered.
 - Templates do potentially save time, since core information can be saved and doesn’t need to be re-entered in each permit.
 - Entering a Permit
 - Overview
 - Once permits are submitted, you will no longer be able to view them.
 - Although you can save a copy of every permit prior to submitting (Save As New (Copy), it may get confusing paging through permits already submitted and new permits.
 - It would be more advisable to “Print” hard copies or “Print” to an image file such as a pdf writer or Microsoft Office Image Writer which will digitally save the file. This will keep your number of web permits down to a manageable number.
 - Create a template
 - A template could contain the base information such as company information, type of work, type of well, email addresses you want the approved permit information emailed to, etc. This will allow you to not have to re-enter data that is common to “MOST” of the permits applied for.
 - After entering the common data – click “Save”. This template will then be saved.
 - You can have multiple templates in your system.
 - Using a template to enter a new permit or click on “New Blank (Reset)” to start new.
 - Using “View Previous” or “View Next”, browse to the template you would like to base your permit on
 - Click “Save As New (Copy)” to create a copy of the template.

Preliminary Permitting steps

- ▣ Form 1H e-Permit
- ▣ Email attachments to apd@nd.gov: Certified surveyor's plat, horizontal section plat, geo tops, proposed mud/cementing plans, directional plot/plan
 - \$100 fee credit card or check
- ▣ Permit submitted into NDIC Queue

Addressing Permitting issues

Form 1 vs. attachments. Correct?

Plats-Well location, Horizontal section, C/F diagram

Google Earth (topo)

Proximity to map area reviews

Bonding

Pierre Shale (min. surface casing depth)

Magnetic Declination

Field Orders

Setbacks/hard lines

Workflow Module Stages

- Stage 0: SUBMITTED TO NDIC
- Stage 1: RECEIVED: Are all attachments in?
- Stage 2: VERIFY: Attachments to FM 1, map features
- Stage 3: RESEARCH: Orders, Pierre top, hard lines
- Stage 4: PERMIT: Review & permit when satisfied.

Final APD approval

- ▣ e-Permit transferred to RBDMS (calc HL)
- ▣ APPROVE and system generates FM 1H & permit letter.
- ▣ Email to permit & MWD survey guidelines letter directly to operator immediately
- ▣ Send secretaries notification for permit fee.
- ▣ Required open hole logs: resistivity & porosity. May request log waiver if control in area.
- ▣ PERMIT STIPULATIONS

Permit Letter



Oil and Gas Division

Lynn D. Helms - Director Bruce E. Hicks - Assistant Director

Department of Mineral Resources

Lynn D. Helms - Director

North Dakota Industrial Commission

www.oilgas.nd.gov

October 7, 2010

Angie M. Rawlinson
Engineering Technician
MUREX PETROLEUM CORPORATION
515 N. Sam Houston Pkwy East, Suite 485
Houston, TX 77060

RE: **HORIZONTAL WELL
VANESSA ABIGAIL 33-28H
SWSW Section 33-157N-95W
Williams County
Well File # 19540**

Dear Angie :

Pursuant to Commission Order No. 15059, approval to drill the above captioned well is hereby given. The approval is granted on the condition that all portions of the well bore not isolated by cement, be no closer than the 200' setback from the north & south boundaries and 500' setback from the east & west boundaries within the 1280 acre spacing unit consisting of sections 33 & 28, T157N, R95W.

PERMIT STIPULATIONS: Be advised the Nelson #13-28 SWD (5612) well is within 300 feet of the proposed wellbore for the Vanessa Abigail #33-28H well. Precautions must be taken while designing the frac job for the Vanessa Abigail #33-28H well as to not adversely affect the Nelson #13-28 SWD (5612) well. Tool error is not required pursuant to Order 15059.

New Policy

Operators shall not commence operations on a drill site until the 3rd business day following publication of the approved drilling permit on the NDIC - OGD Daily Activity Report. If circumstances require operations to commence before the 3rd business day following publication on the Daily Activity Report, the waiting period may be waived by the Director. Application for a waiver must be by sworn affidavit providing the information necessary to evaluate the extenuating circumstances, the factors of NDAC 43-02-03-16.2 (1), (a)-(f), and any other information that would allow the Director to conclude that in the event another owner seeks revocation of the drilling permit, the applicant should retain the permit.

Permit Fee & Notification

Payment was received in the amount of \$100 via credit card. The permit fee has been received. It is requested that notification be given immediately upon the spudding of the well. This information should be relayed to the Oil & Gas Division, Bismarck, via telephone. The following information must be included: Well name, legal location, permit number, drilling contractor, company representative, date and time of spudding. Office hours are 8:00 a.m. to 12:00 p.m. and 1:00 p.m. to 5:00 p.m. Central Time. Our telephone number is (701) 328-8020, leave a message if after hours or on the weekend.

Angie M. Rawlinson
October 7, 2010
Page 2

Survey Requirements for Horizontal, Horizontal Re-entry, and Directional Wells

NDAC Section 43-02-03-25 (Deviation Tests and Directional Surveys) states in part (that) the survey contractor shall file a certified copy of all surveys with the director free of charge within thirty days of completion. Surveys must be submitted as one electronic copy, or in a form approved by the director. However, the director may require the directional survey to be filed immediately after completion if the survey is needed to conduct the operation of the director's office in a timely manner. Certified surveys must be submitted via email in one adobe document, with a certification cover page to certsurvey@nd.gov. Survey points shall be of such frequency to accurately determine the entire location of the well bore.

Reserve pit

Please be advised that conditions may be imposed on the use and reclamation of a drilling reserve pit on this site if specific site conditions warrant.

Surface casing cement

Tail cement utilized on surface casing must have a minimum compressive strength of 500 psi within 12 hours, and tail cement utilized on production casing must have a minimum compressive strength of 500 psi before drilling the plug or initiating tests.

Logs

NDAC Section 43-02-03-31 requires the running of a Cement Bond Log from which the presence of cement can be determined in every well in which production or intermediate casing has been set and a Gamma Ray Log must be run from total depth to ground level elevation of the well bore. All logs must be submitted as one paper copy and one digital copy in LAS (Log ASCII) format, or a format approved by the Director. Image logs that include, but are not limited to, Mud Logs, Cement Bond Logs, and Cyberlook Logs, cannot be produced in their entirety as LAS (Log ASCII) files. To create a solution and establish a standard format for industry to follow when submitting image logs, the Director has given approval for the operator to submit an image log as a TIFF (*.tif) formatted file. The TIFF (*.tif) format will be accepted only when the log cannot be produced in its entirety as a LAS (Log ASCII) file format. The digital copy may be submitted on a 3.5" floppy diskette, a standard CD, or attached to an email sent to digitallogs@nd.gov. Thank you for your cooperation.

Sincerely,

Dave McCusker
Petroleum Engineer

Permit Stipulations

- ▣ Based on environmental factors
 - Topography (rough terrain)
 - ▣ Closed system, no drilling pit
 - Aquifers in the area
 - Distance to a body of water
- ▣ Based on additional wells on the pad
 - Closed system, cuttings pit only.
- ▣ MULTI WELL PADS--We prefer operators submit only the wells which will be drilled consecutively on the pad. I.E. if 4 wells are noted on the pad we'll assume all will be drilled back to back.

FORM 1H



APPLICATION FOR PERMIT TO DRILL HORIZONTAL WELL - FORM 1H

INDUSTRIAL COMMISSION OF NORTH DAKOTA
OIL AND GAS DIVISION
600 EAST BOULEVARD DEPT 405
BISMARCK, ND 58505-0840
SFN 54269 (08-2005)

PLEASE READ INSTRUCTIONS BEFORE FILLING OUT FORM.
PLEASE SUBMIT THE ORIGINAL AND ONE COPY.

Type of Work New Location	Type of Well Oil & Gas	Approximate Date Work Will Start 9 / 13 / 2010	Confidential Status No
Operator MUREX PETROLEUM CORPORATION		Telephone Number 281-590-3313	
Address 515 N. Sam Houston Pkwy East, Suite 485		City Houston	State TX
		Zip Code 77060	

Notice has been provided to the owner of any permanently occupied dwelling within 1,320 feet. This well is not located within five hundred feet of an occupied dwelling.

WELL INFORMATION (If more than one lateral proposed, enter data for additional laterals on page 2)

Well Name VANESSA ABIGAIL		Well Number 33-28H	
Surface Footages 300 F S L 570 F W L	Qtr-Qtr SWSW	Section 33	Township 157 N
Range 95 W	County Williams		
Longstring Casing Point Footages 740 F S L 583 F W L	Qtr-Qtr SWSW	Section 33	Township 157 N
Range 95 W	County Williams		
Longstring Casing Point Coordinates From Well Head 440 N From WH 13 E From WH	Azimuth 1.69 °	Longstring Total Depth 9981 Feet MD	Estimated Total Depth Lateral 9729 Feet TVD
Bottom Hole Footages From Nearest Section Line 201 F N L 866 F W L	Qtr-Qtr NWNW	Section 28	Township 157 N
Range 95 W	County Williams		
Bottom Hole Coordinates From Well Head 10068 N From WH 296 E From WH	KOP Lateral 1 9288 Feet MD	Azimuth Lateral 1 1.69 °	Estimated Total Depth Lateral 1 19612 Feet MD 9729 Feet TVD
Latitude of Well Head 48 ° 22 ' 24.08 "	Longitude of Well Head -102 ° 58 ' 12.92 "	NAD Reference NAD83	Description of (Subject to NDIC Approval) Spacing Unit: sections 33 & 28, T157N, R95W
Ground Elevation 2323 Feet Above S.L.	Acres in Spacing/Drilling Unit 1280	Spacing/Drilling Unit Setback Requirement 200 Feet N/S	Industrial Commission Order 500 Feet E/W 15059
North Line of Spacing/Drilling Unit 5281 Feet	South Line of Spacing/Drilling Unit 5281 Feet	East Line of Spacing/Drilling Unit 10565 Feet	West Line of Spacing/Drilling Unit 10569 Feet
Objective Horizons Bakken		Pierre Shale Top 1643	
Proposed Surface Casing 9 - 5/8 "	Size 36 Lb./Ft.	Depth 1720 Feet	Cement Volume 500 Sacks
NOTE: Surface hole must be drilled with fresh water and surface casing must be cemented back to surface.			
Proposed Longstring Casing 7 - "	Size 29-32 Lb./Ft.	Weight(s) 9981 Feet MD	Longstring Total Depth 9729 Feet TVD
Base Last Charles Salt (If Applicable) 8213 Feet		NOTE: Intermediate or longstring casing string must be cemented above the top Dakota Group Sand.	
Proposed Logs mudlogs / MWD GR / CBL w/GR to surf			
Drilling Mud Type (Vertical Hole - Below Surface Casing) Invert		Drilling Mud Type (Lateral) Brine	
Survey Type in Vertical Portion of Well Gyro MS Every 100 Feet	Survey Frequency: Build Section 30 Feet	Survey Frequency: Lateral 90 Feet	Survey Contractor Pathfinder

NOTE: A Gamma Ray log must be run to ground surface and a CBL must be run on intermediate or longstring casing string if set.

Surveys are required at least every 30 feet in the build section and every 90 feet in the lateral section of a horizontal well. Measurement inaccuracies are not considered when determining compliance with the spacing/drilling unit boundary setback requirement except in the following scenarios: 1) When the angle between the well bore and the respective boundary is 10 degrees or less and the well bore is within 150 feet of the respective setback requirement; or 2) If industry standard methods and equipment are not utilized. Consult the applicable field order for exceptions.

If measurement inaccuracies are required to be considered, a 2" MWD measurement inaccuracy will be applied to the horizontal portion of the well bore. This measurement inaccuracy is applied to the well bore from KOP to TD.

REQUIRED ATTACHMENTS: Certified surveyor's plat, horizontal section plat, estimated geological tops, proposed mud/cementing plan, directional plot/plan, \$100 fee.
See Page 2 for Comments section and signature block.

Page 2
SFN 54269 (08-2005)

COMMENTS, ADDITIONAL INFORMATION, AND/OR LIST OF ATTACHMENTS

This is the 2nd well in this spacing unit. The first is the LeAnn Rae #28-33H file #16035.

Lateral 2

KOP Lateral 2 Feet MD	Azimuth Lateral 2 °	Estimated Total Depth Lateral 2 Feet MD	Feet TVD	KOP Coordinates From Well Head From WH From WH	
Formation Entry Point Coordinates From Well Head From WH From WH		Bottom Hole Coordinates From Well Head From WH From WH			
KOP Footages From Nearest Section Line F L F L		Qtr-Qtr	Section	Township N	Range W
Bottom Hole Footages From Nearest Section Line F L F L		Qtr-Qtr	Section	Township N	Range W

Lateral 3

KOP Lateral 3 Feet MD	Azimuth Lateral 3 °	Estimated Total Depth Lateral 3 Feet MD	Feet TVD	KOP Coordinates From Well Head From WH From WH	
Formation Entry Point Coordinates From Well Head From WH From WH		Bottom Hole Coordinates From Well Head From WH From WH			
KOP Footages From Nearest Section Line F L F L		Qtr-Qtr	Section	Township N	Range W
Bottom Hole Footages From Nearest Section Line F L F L		Qtr-Qtr	Section	Township N	Range W

Lateral 4

KOP Lateral 4 Feet MD	Azimuth Lateral 4 °	Estimated Total Depth Lateral 4 Feet MD	Feet TVD	KOP Coordinates From Well Head From WH From WH	
Formation Entry Point Coordinates From Well Head From WH From WH		Bottom Hole Coordinates From Well Head From WH From WH			
KOP Footages From Nearest Section Line F L F L		Qtr-Qtr	Section	Township N	Range W
Bottom Hole Footages From Nearest Section Line F L F L		Qtr-Qtr	Section	Township N	Range W

Lateral 5

KOP Lateral 5 Feet MD	Azimuth Lateral 5 °	Estimated Total Depth Lateral 5 Feet MD	Feet TVD	KOP Coordinates From Well Head From WH From WH	
Formation Entry Point Coordinates From Well Head From WH From WH		Bottom Hole Coordinates From Well Head From WH From WH			
KOP Footages From Nearest Section Line F L F L		Qtr-Qtr	Section	Township N	Range W
Bottom Hole Footages From Nearest Section Line F L F L		Qtr-Qtr	Section	Township N	Range W

I hereby swear or affirm the information provided is true, complete and correct as determined from all available records. Date **8 / 30 / 2010**

ePermit	Printed Name Angie M. Rawlinson	Title Engineering Technician
----------------	---	--

FOR STATE USE ONLY

Permit and File Number 19540	API Number 33 - 105 - 01958
Field MIDWAY	
Pool BAKKEN	Permit Type DEVELOPMENT

FOR STATE USE ONLY

Date Approved 9 / 14 / 2010
By Dave McCusker
Title Petroleum Engineer

PLAT REQUIREMENTS

NDIC Oil & Gas Division requires

- Certified well location plat,
- Certified Horizontal Section plat
- Certified Bottom Hole Location plat
- Certified Cut and Fill Diagrams
 - Pad Layout Design.
 - Pad layout volumetrics (Cubic yards used, acreage of pad).
- Good and Bad Examples of each.

Well Location Plat requirements

- ▣ Prepared in accordance with NDCC 40-50.1.
 - MONUMENTS – “EXCECUTED WITH GREAT CARE”
 - NDPLS guidelines: “ Ascertain that the monuments used to determine section lines are the section corner monuments according to the rules as defined by the BLM Manual of Instructions. Land Surveyor is responsible for rehabilitating monuments and corner recordation.
- ▣ Plat Must have ND Stamp. Must be RLS in ND Per NDCC 43-19.1-01
- ▣ Must depict ground level at well head.
- ▣ Plats referenced to True North.

Needs True North Reference

WELL LOCATION PLAT

TEL: 307-875-3630
FAX: 307-875-3640




1675 FEET FROM
2000 FEET FROM

E LOCATION)
E LOCATION)

COMPANY
4-9H
E LOCATION)
27"
.03"
83
95'
GROUND
23"
.41"
27
56'

COMPANY
4-9H
LOCATION)
98"
5.93"
83
48'
94"
27
1.32"
00'

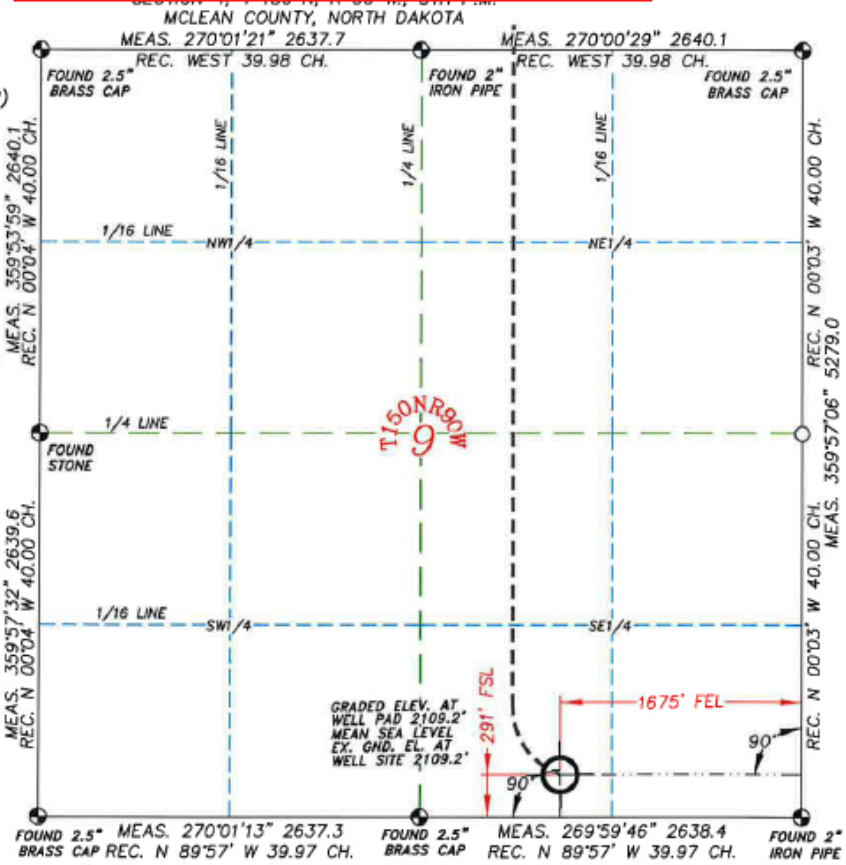

LEGEND

- FOUND CORNER
- ⊗ CALCULATED CORNER
- NOTHING FOUND

being of the 5th P.M., Mclean County, State of North Dakota.
Surface Hole Elevation of ungraded ground is 2109.2 ft

Notes: All Azimuths are based on the South line of the Southeast Quarter of Section 4, T150N R90W of the 5th P.M., being an Azimuth of 269°59'46" using GPS observations, occupying a WHS control point (5/8" rebar) and having the Location and Elevation derived from an OPUS Solution. Azimuths shown have been rotated 1°16'05.36010" West from SPC Grid bearings to Geodetic North, based on convergence angle provided by a conversion using Corpscon. Vertical Datum used is of NAVD 88. Control Point is located 271°16'16" 1032.72 ft. from the SW Section Corner of Section 4, T150N R90W of the 5th P.M.




Horizontal Section Plats

- ▣ Prepared in accordance with NDCC 40-50.1.
 - Monuments.
- ▣ Plat Must have ND Stamp. Must be RLS in ND
Per NDCC 43-19.1-01
- ▣ Boundary Survey.
 - Submit all plats which define the spacing unit. (i.e.:
2- “640” acre plats if “1280” acre spacing unit).
- ▣ Depict all $\frac{1}{4}$ section distances.

HORIZONTAL SECTION PLAT

6300 Bridgeway (location)
 450 feet from (hole target)
 250 feet from (hole target)
 Latitude 48°18' (location)
 Latitude 48°20' (hole target)

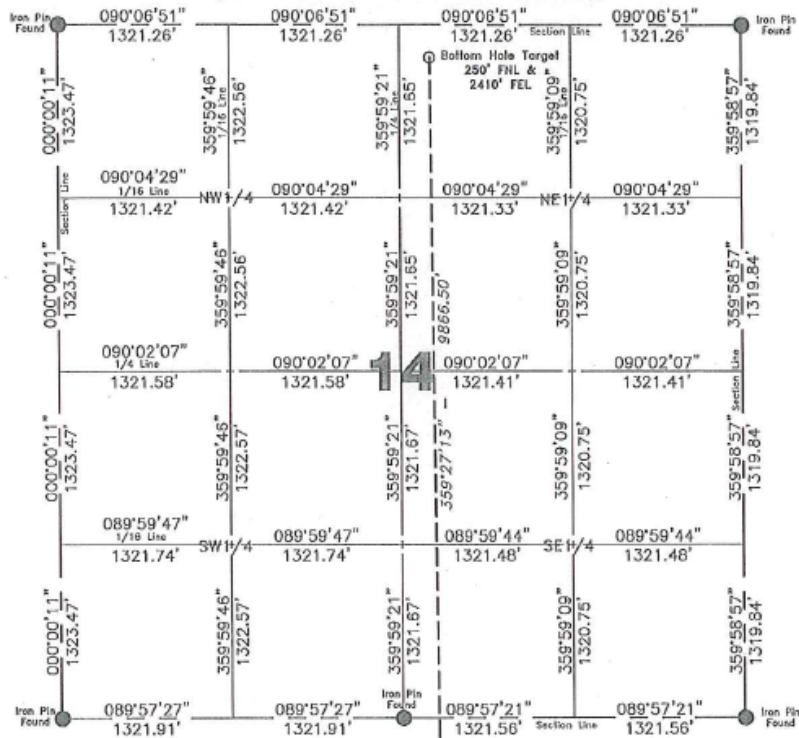

Scale 1"=1000'

Confidentiality Notice: The information contained on this plat is legally privileged and confidential information intended only for the use of recipients. If you are not the intended recipient, you are hereby notified that any use, dissemination, distribution or copying of this information is strictly prohibited.

I, Alvin R. Lambert, Professional Land Surveyor, N.O. No. 1241, do hereby certify that the survey plot shown hereon was made by me, or under my direction, from notes made in the field, and the same is true and correct to the best of my knowledge and belief.

All corners shown on this plat were found in the field during Brigham Oil & Gas, LP Barstad 23-14 #2H oil well survey on 04/11/2011. Distances to all others are calculated. All azimuths are based on the west line of Section 23, being on an azimuth of 000°02'36\".




Alvin R. Lambert
 ALVIN R. LAMBERT
 PROFESSIONAL LAND SURVEYOR
 NORTH DAKOTA

4/27/11
 DATE



HORIZONTAL SECTION PLAT

6300 E [redacted] Texas 78730
 450 feet from [redacted] (surface location)
 250 feet from [redacted] (bottom hole target)
 Latitude 48° [redacted] (surface location)
 Latitude 48° [redacted] (bottom hole target)

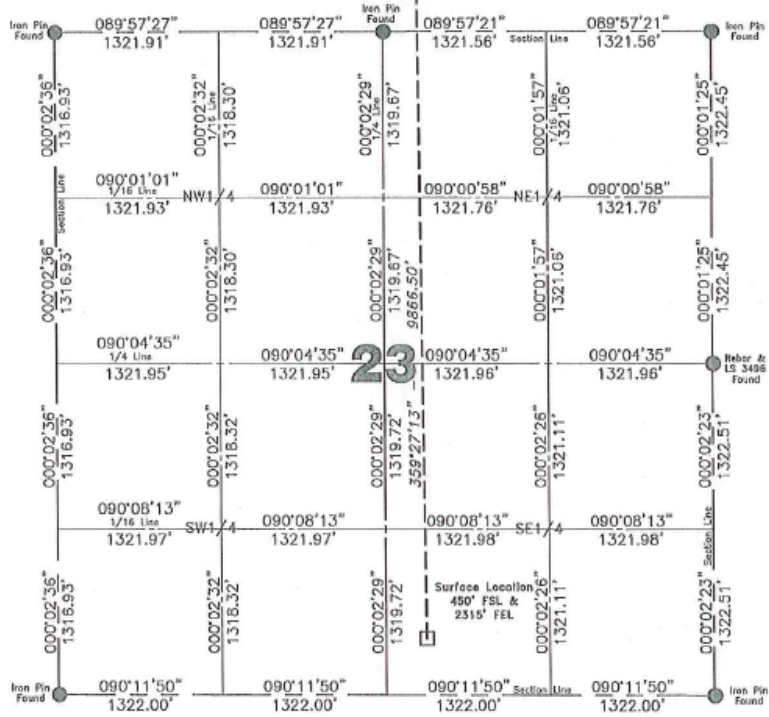

Scale 1"=1000'

Confidentiality Notice: The information contained on this plot is legally privileged and confidential information intended only for the use of recipients. If you are not the intended recipient, you are hereby notified that any use, dissemination, distribution or copying of this information is strictly prohibited.

I, Alvin R. Lambert, Professional Land Surveyor, N.D. No. 1241, do hereby certify that the survey plot shown hereon was made by me, or under my direction, from notes made by-the-field, and the same is true and correct to the best of my knowledge and belief.

All corners shown on this plot were found in the field during Brigham Oil & Gas, LP Barstad 23-14 #2H oil well survey on 04/11/2011. Distances to all others are calculated. All azimuths are based on the west line of Section 23, being on an azimuth of 000°02'36".

[redacted]


4/27/11
 DATE

[redacted]

[redacted]

Cut and Fill Diagram

- ▣ Prepared in accordance with NDCC 40-50.1.
 - Must be stamped by a registered land surveyor or engineer.
- ▣ Pad cannot be located in a drainage or hazardously near a body of water.
 - Pad Layout Design
 - Typical Cross Sections
- ▣ Cut and Fill diagram
 - Depict Cut and Fill on corners of pit
 - ▣ NO FILL in Pit (or corners) per NDAC 43-02-03-19
 - Depict Cut and Fill on corners of the location
 - Depict Cut and Fill at the well head

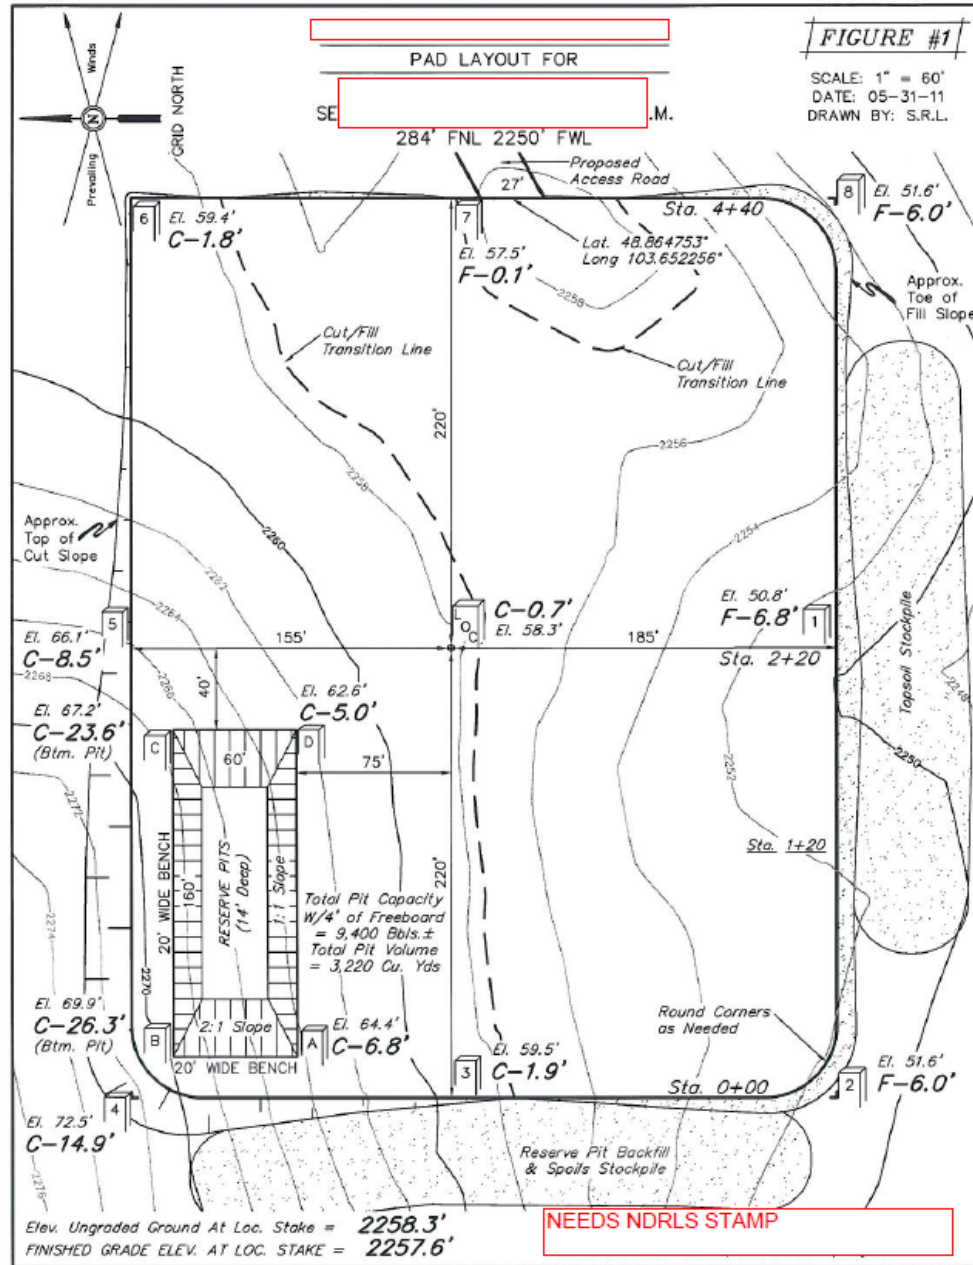

Typical Cross Section/volumetrics

- ▣ Must contain volume of dirt disturbed
- ▣ Must contain acreage of the pad


X-Section
Scale
1" = 100'

DATE: 05-31-11
DRAWN BY: S.R.L.
REVISED: 6-6-11

TYPICAL CROSS SECTIONS FOR

284' FNL 2250' FWL

FIGURE #2

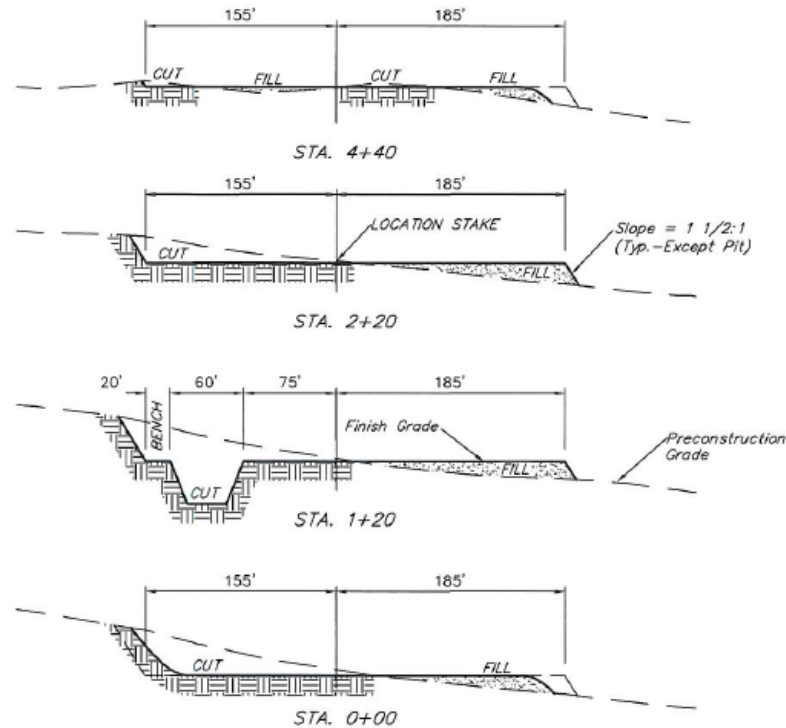

APPROXIMATE ACREAGES
WELL SITE DISTURBANCE = ± 3.714 ACRES
ACCESS ROAD DISTURBANCE = ± 1.480 ACRES
TOTAL = ± 5.194 ACRES

* NOTE:
FILL QUANTITY INCLUDES
5% FOR COMPACTION

APPROXIMATE YARDAGES

(6") Topsoil Stripping = 3,080 Cu. Yds.
Remaining Location = 9,670 Cu. Yds.
Reserve Pit Cut = 3,220 Cu. Yds.
TOTAL CUT = 15,970 CU.YDS.
FILL = 10,030 CU.YDS.

EXCESS MATERIAL = 5,940 Cu. Yds.
Topsoil & Pit Backfill = 4,690 Cu. Yds.
(1/2 Pit Vol.)
EXCESS UNBALANCE = 1,250 Cu. Yds.
(After Interim Rehabilitation)

Bars [redacted] 2H

Sect [redacted] M.

Mountrail County, North Dakota

Barstad 23-14 #1H	2324.4' MSL
Barstad 23-14 #2H	2324.9' MSL
Barstad 23-14 #3H	2325.6' MSL
Well Pad Elevation	2321.1' MSL

Excavation	17,440 C.Y.
Plus Pit	2,050 C.Y.
	<hr/>
	19,490 C.Y.

Embankment	9,485 C.Y.
Plus Shrinkage (+30%)	2,845 C.Y.
	<hr/>
	12,330 C.Y.


Stockpile Pit	2,050 C.Y.
Stockpile Top Soil (6")	4,765 C.Y.
Road Embankment & Stockpile from Pad	345 C.Y.

Disturbed Area From Pad 5.91 Acres

NOTE :

All cut end slopes are designed at 1:1 slopes &
all fill end slopes are designed at 1 1/2:1 slopes

<u>Barstad 23-14 #1H</u>	<u>Barstad 23-14 #2H</u>	<u>Barstad 23-14 #3H</u>
450' FSL	450' FSL	450' FSL
2340' FEL	2315' FEL	2290' FEL

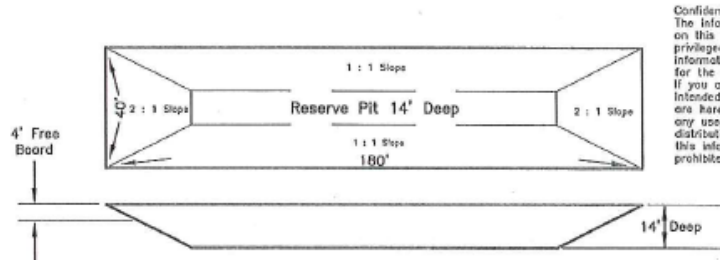


Confidentially Notice:
The information contained
on this plot is legally
privileged and confidential
information intended only
for the use of recipients.
If you are not the
intended recipients, you
are hereby notified that
any use, dissemination,
distribution or copying of
this information is strictly
prohibited.

"Good" well location plats

WELL LOCATION PLAT

5th P.M.

R94W, 5th P.M., Dunn County, North Dakota

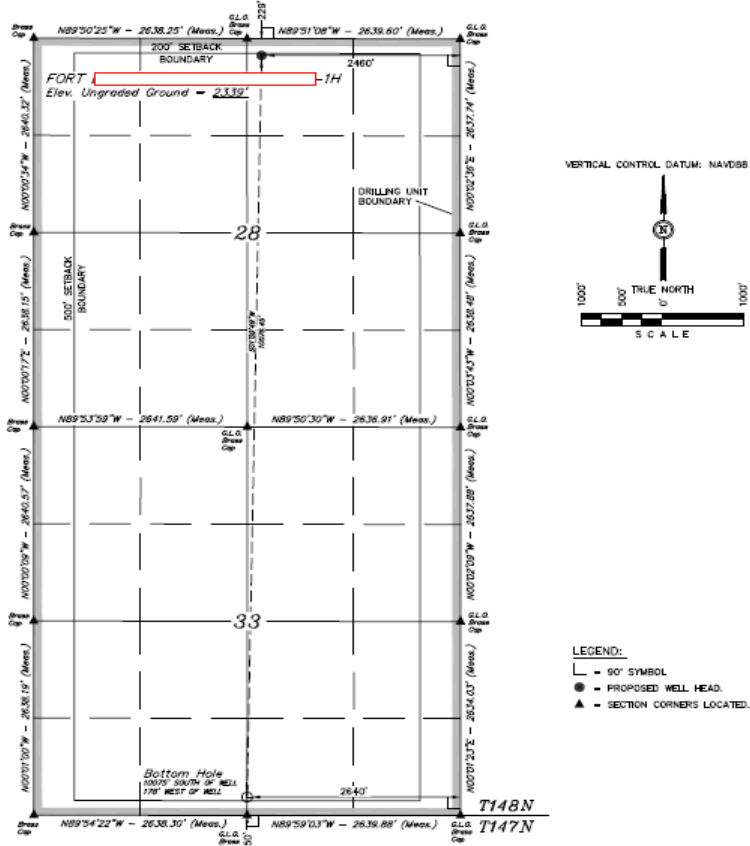

T148N


T147N

REVISED: 10-26-11 M.D.
REVISED: 08-09-11 P.M.
(Issued from N.D.S. OP&S. Station REF PLATE: NAD_83(200888)) (SICR 2002.0000)

NAD 83 (TANKSET BOTTOM HOLE)	NAD 83 (SURFACE LOCATION)
LATITUDE = 47°30'20.46" (47.505935)	LATITUDE = 47°30'58.81" (47.516642)
LONGITUDE = 102°39'45.88" (102.660772)	LONGITUDE = 102°39'45.57" (102.660335)
NAD 27 (TANKSET BOTTOM HOLE)	NAD 27 (SURFACE LOCATION)
LATITUDE = 47°30'20.45" (47.506014)	LATITUDE = 47°30'58.80" (47.516623)
LONGITUDE = 102°39'44.31" (102.592326)	LONGITUDE = 102°39'41.89" (102.591636)

CERTIFICATE
I HEREBY CERTIFY THAT THIS PLAT CORRECTLY REPRESENTS WORK PERFORMED BY ME OR UNDER MY DIRECT SUPERVISION AND IN FULL AND CORRECT TO THE BEST OF MY KNOWLEDGE AND BELIEF.

STATE OF NORTH DAKOTA

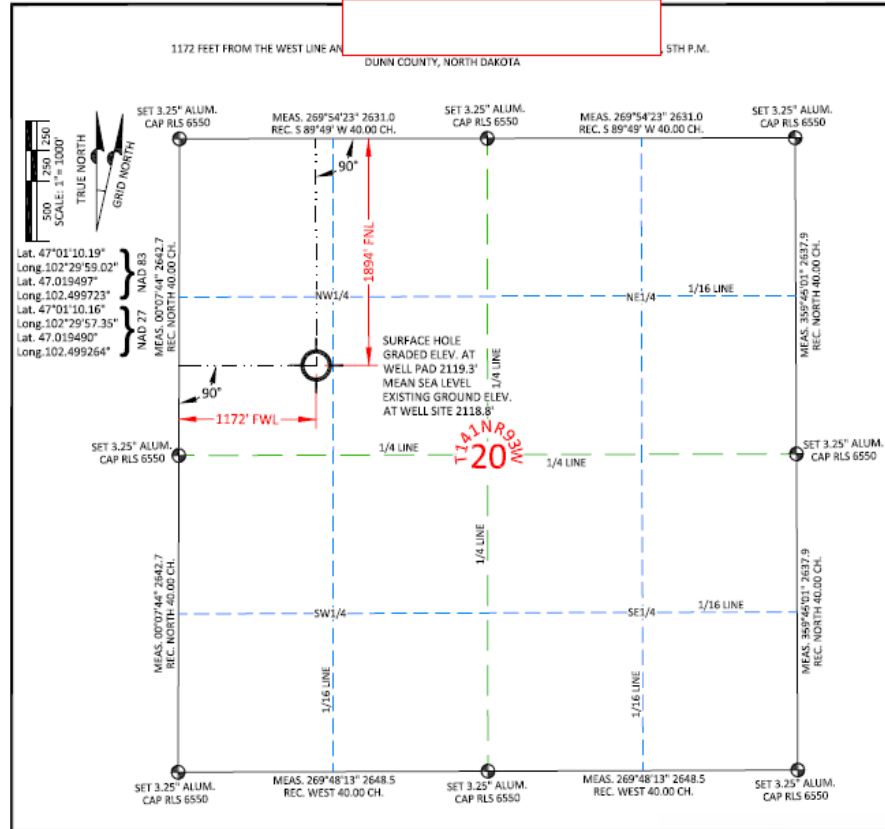

Notes: All Azimuths are based on the West line of the Northwest quarter of Section 20, T141N R93W of the 5th P.M., being an Azimuth of 00°07'44" using GPS observations, occupying a WHS control point (5/8" rebar) and having the Location and Elevation derived from an OPUS Solution. Azimuths shown have been rotated 1°26'48.18773" West from SPC Grid bearings to Geodetic North, based on convergence angle provided by a conversion using Corpcorn.
Vertical Datum used is of NAVD 88.
Control Point is located 357°48'05" 1093.2 ft. from the Northeast Corner of Section 20, T141N R93W of the 5th P.M.
Distances shown are Ground Distances using a combined scale factor of 1.000160734
Location shown here on is not an "ASBUILT" location.

CONFIDENTIALITY NOTES:
The information contained in this plat is legally privileged and confidential information intended only for the use of the recipients. If you are not the intended recipients, you are hereby notified that any use, dissemination, distribution or copying of this information is strictly prohibited.

LEGEND	LOCATION OF PLATTED WELL
● FOUND/SET CORNER	SW1/4 NW1/4, SEC. 20, T141N, R93W,
⊗ CALCULATED CORNER	
○ NOTHING FOUND	



“Good” well location Plat


WELL LOCATION PLAT

250 feet from the south line and 1900 feet from the east line (surface location Section 10)
 250 feet from the north line and 1620 feet from the east line (bottom hole target Section 3)

5th Principal Meridian
 North Dakota

Latitude [redacted] (surface location Section 10)
 Latitude [redacted] (bottom hole target Section 3)
 [derived from N.G.S. O.P.U.S. Solution REF FRAME: NAD_83 (COR96)(EPOCH:2002.0000)]

“MONUMENTS NOTED AS
 “FOUND”.

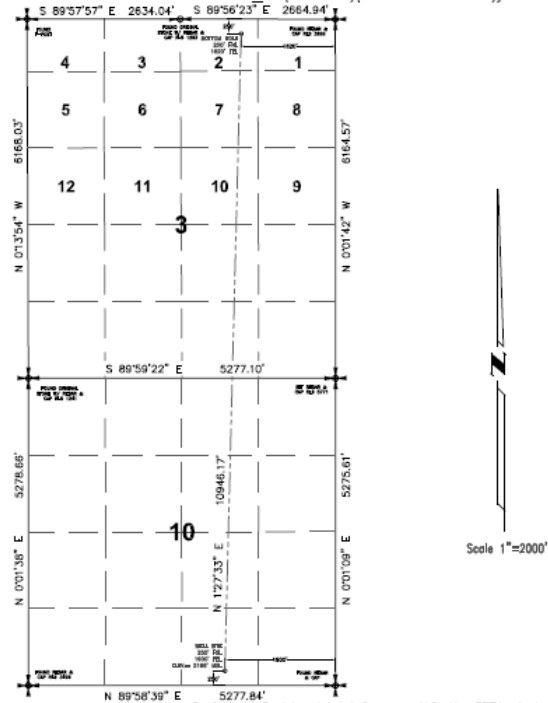


NOTE: All land corners are assumed unless otherwise noted.
 Location shown hereon is a preliminary staked location and is not an as-built.


[redacted]

[redacted]


“Poor” well Location Plat

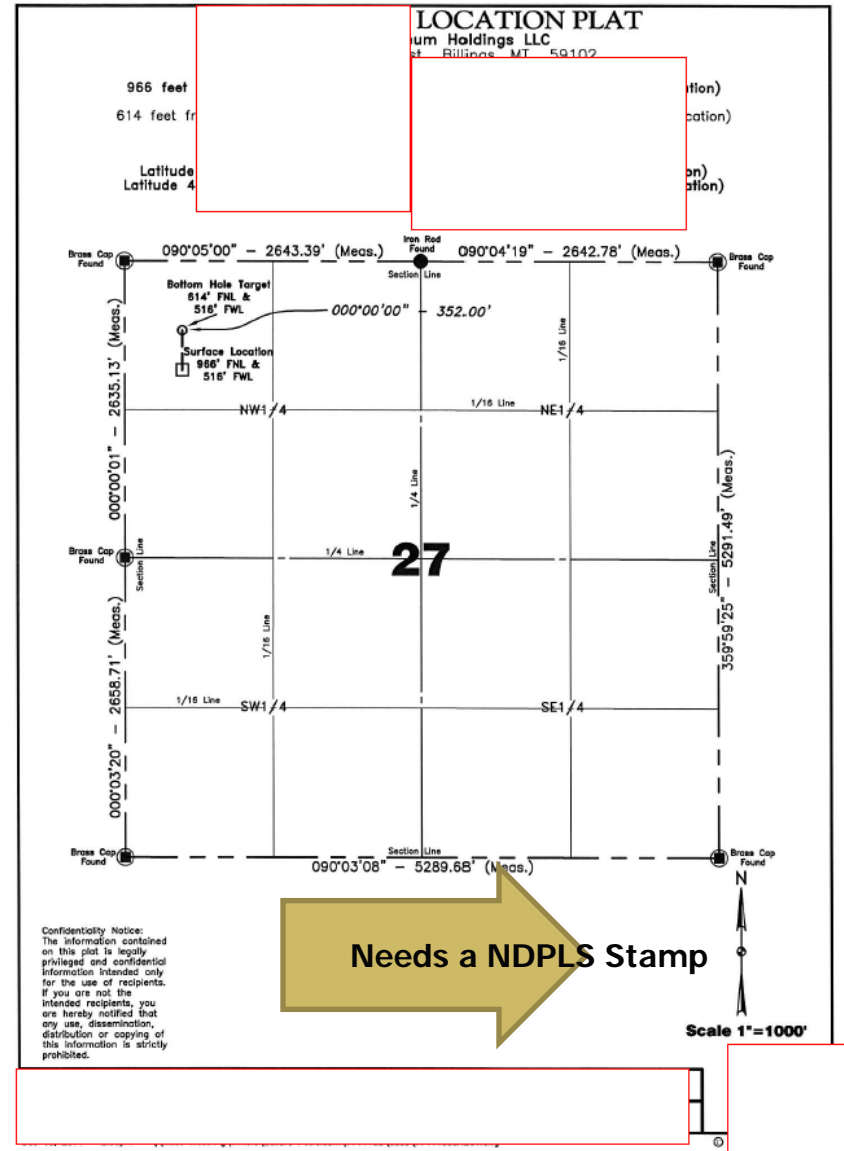


“Poor” horizontal section plats

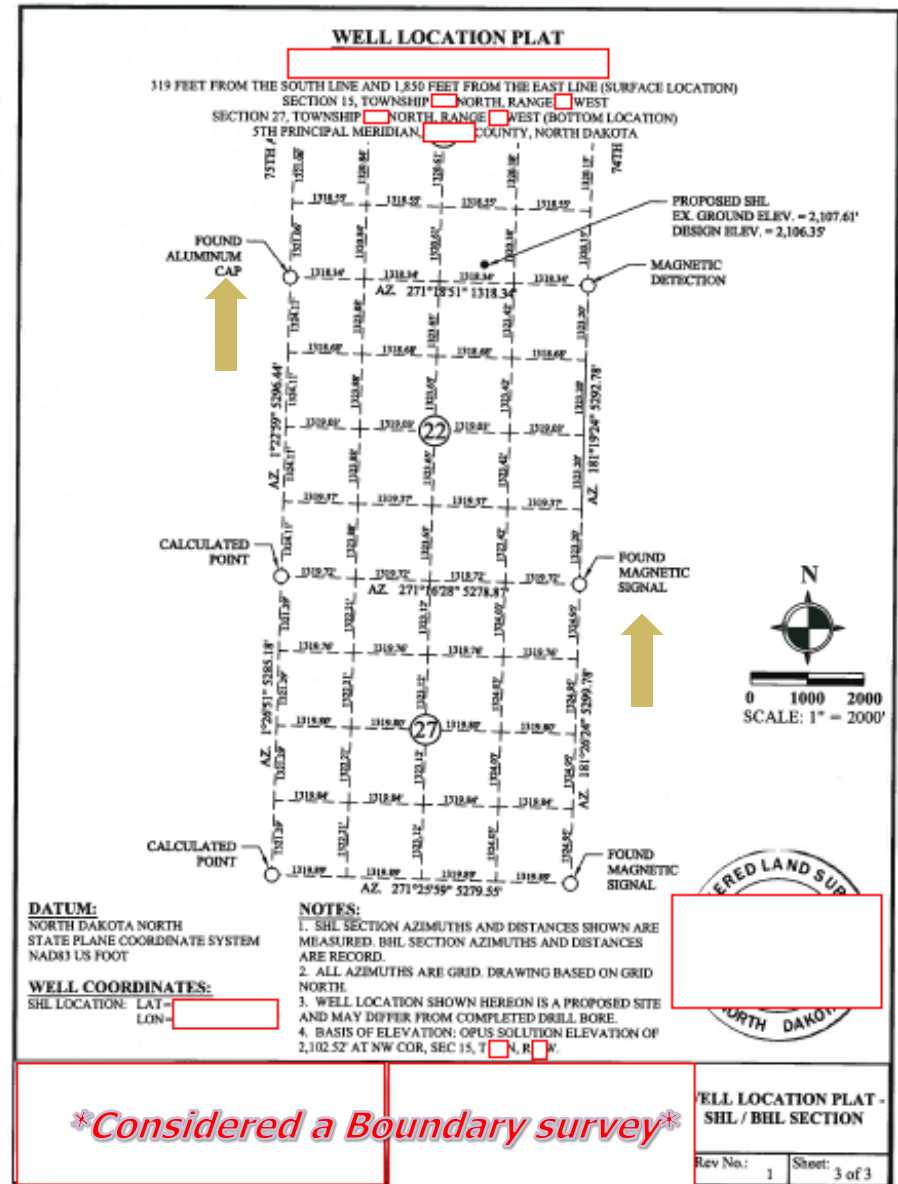

"acceptable" Pad Layout Plat

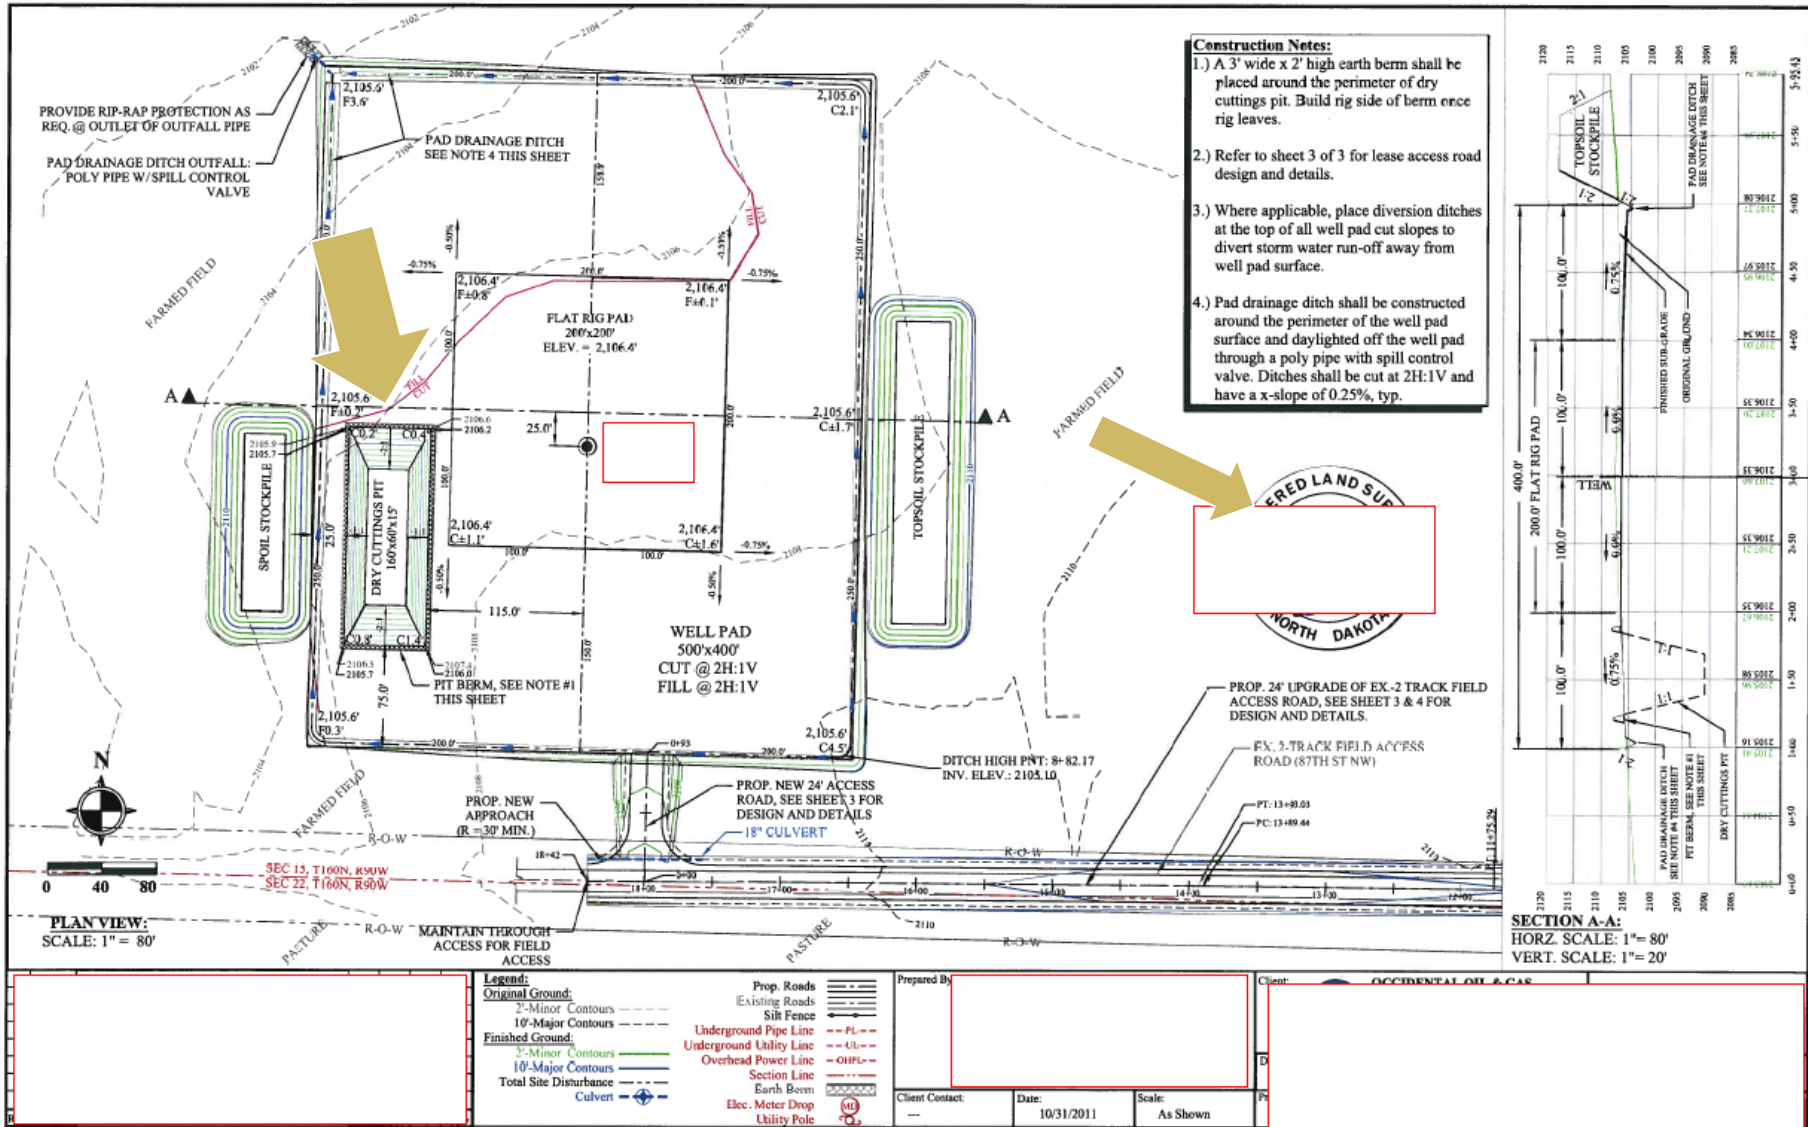

Cross Sections

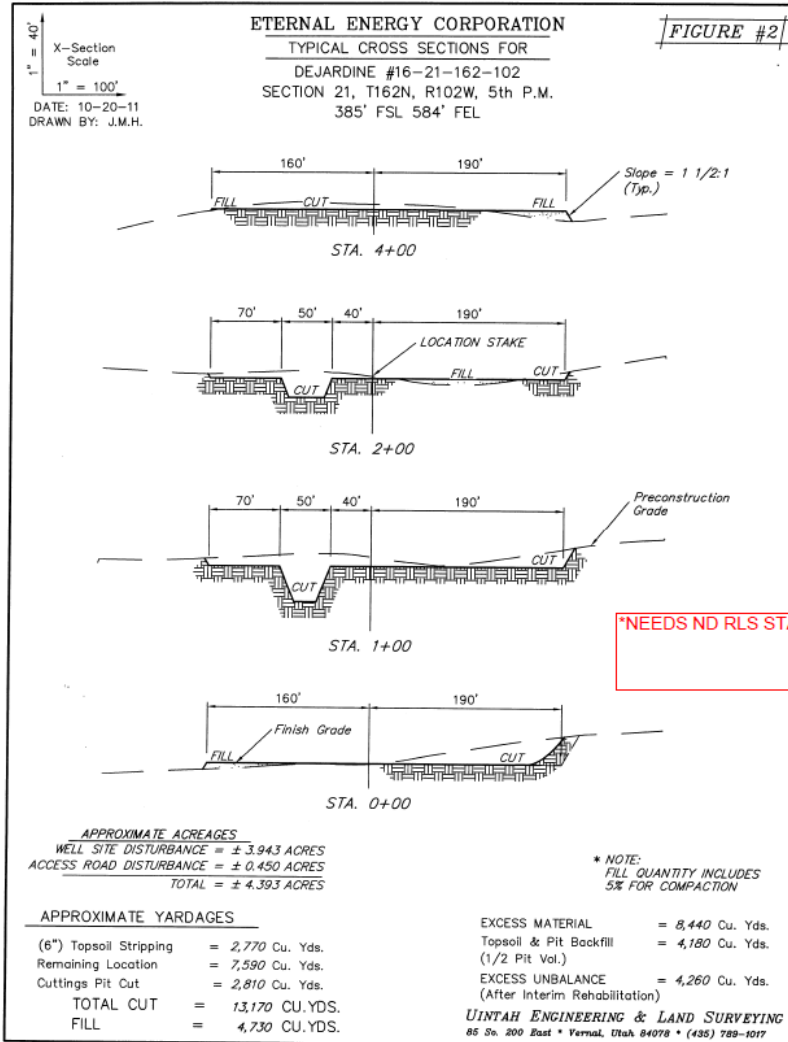


CHANGES?

- ▣ Section Corner MONUMENTATION-reviewing plats much closer.
- ▣ Monument reference notes & symbols.
- ▣ Plats Referenced to True North (always required).
- ▣ April 2010 adopted rule in NDAC which requires Cut/Fill Diagrams.
 - Cut/Fill needs to be noted in corner of Pad as well as Drilling Pit Corners
- ▣ CERTIFICATION STAMP
 - All “well location” plats need to be stamped by a licensed land surveyor
 - All Cut/Fill diagram plats need to be stamped by either a licensed land surveyor or licensed professional engineer.


Riparian Issues

- ▣ Should review original GLO plats as they relate to the current actual water mark.
- ▣ Each situation may be different.
- ▣ Make sure to note all Lots and original GLO water mark.
- ▣ Find original monuments or set if necessary.
- ▣ Original GLO plats online at the State Water Commission website:
<http://survey.swc.nd.gov/>

SECTION BREAKDOWN

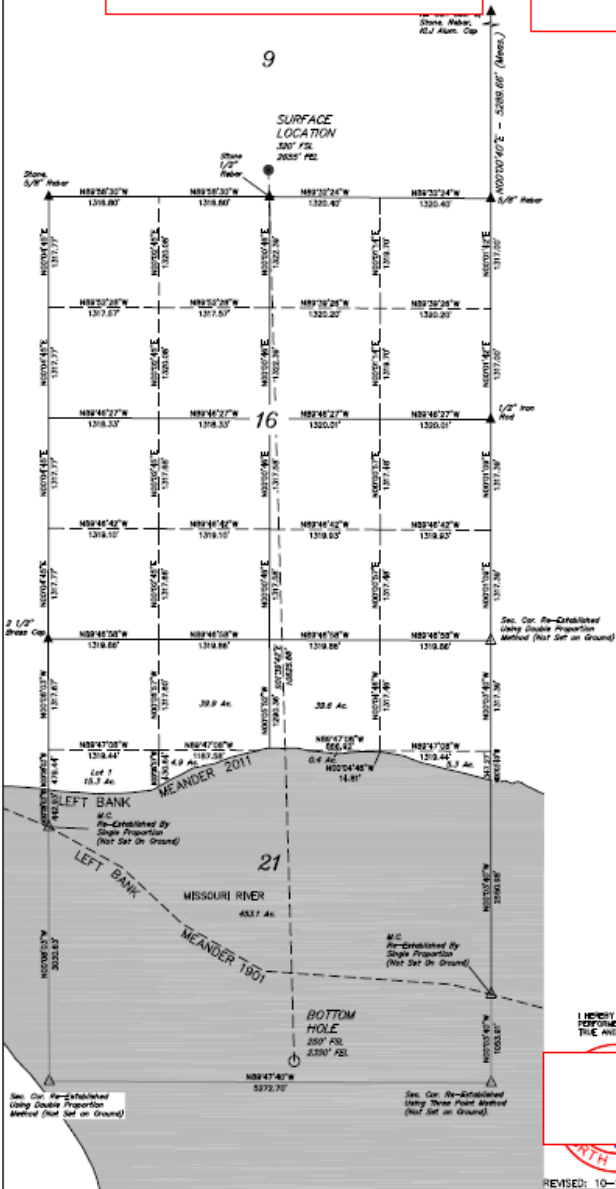

VERTICAL CONTROL DATUM:

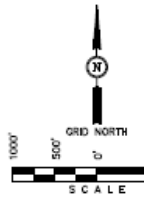

LEGEND:

- 90° SYMBOL
- PROPOSED WELL HEAD
- ▲ SECTION CORNERS LOC
- △ SECTION CORNERS RE- (Not Set on Ground)

CERTIFICATE


I HEREBY CERTIFY THAT THIS PLAN CORRECTLY REPRESENTS BY ME OR UNDER MY DIRECT SUPERVISION TRUE AND CORRECT TO THE BEST OF MY KNOWLEDGE




REGISTRATION NO. 4
STATE OF NORTH DAKOTA

REVISED: 10-14-11

[Sourced from N.G.S. D.P.L.S. Solution 10P FRAME: NAD_83(COR95)EPOCH_2002_0000]	
NAD 83 (TARGET BOTTOM HOLE)	NAD 83 (SURFACE LOCATION)
LATITUDE = 48°07'14.83" (48.034614)	LATITUDE = 48°07'06.25" (48.083285)
LONGITUDE = 102°16'28.68" (102.274608)	LONGITUDE = 102°16'31.27" (102.278125)
NAD 27 (TARGET BOTTOM HOLE)	NAD 27 (SURFACE LOCATION)
LATITUDE = 48°07'14.37" (48.033922)	LATITUDE = 48°04'56.17" (48.082100)
LONGITUDE = 102°16'27.10" (102.877528)	LONGITUDE = 102°16'31.48" (102.882744)

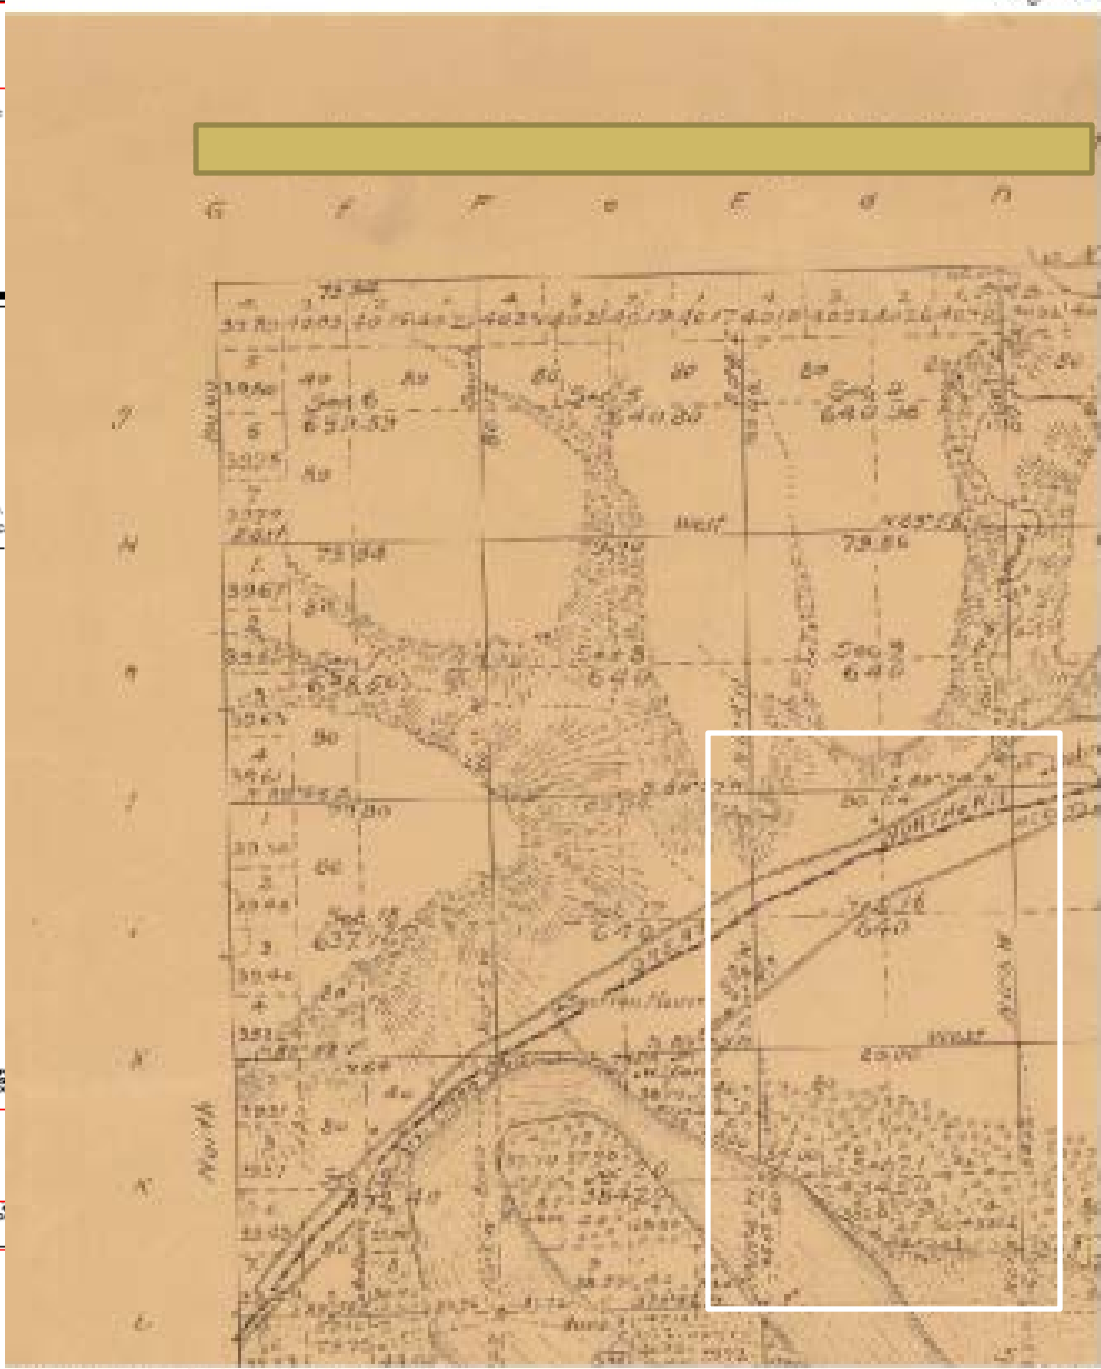


VERTICAL CONTROL DATUM: NAVD88

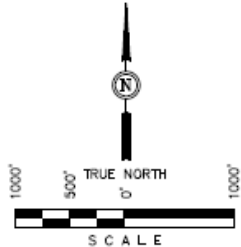


LINE	BEARING	LENGTH
L1	S53°48'52"E	43.07'
L2	S89°57'15"W	249.69'
L3	S15°00'37"E	41.28'
L4	S00°11'36"E	375.50'
L5	N00°12'00"W	295.74'
L6	S89°53'06"W	82.70'
L7	S89°55'46"W	114.25'
L8	S89°57'11"W	79.20'
L9	S89°54'20"W	562.89'

SECTION BREAKDOWN 5th P.M. & 5th P.M.

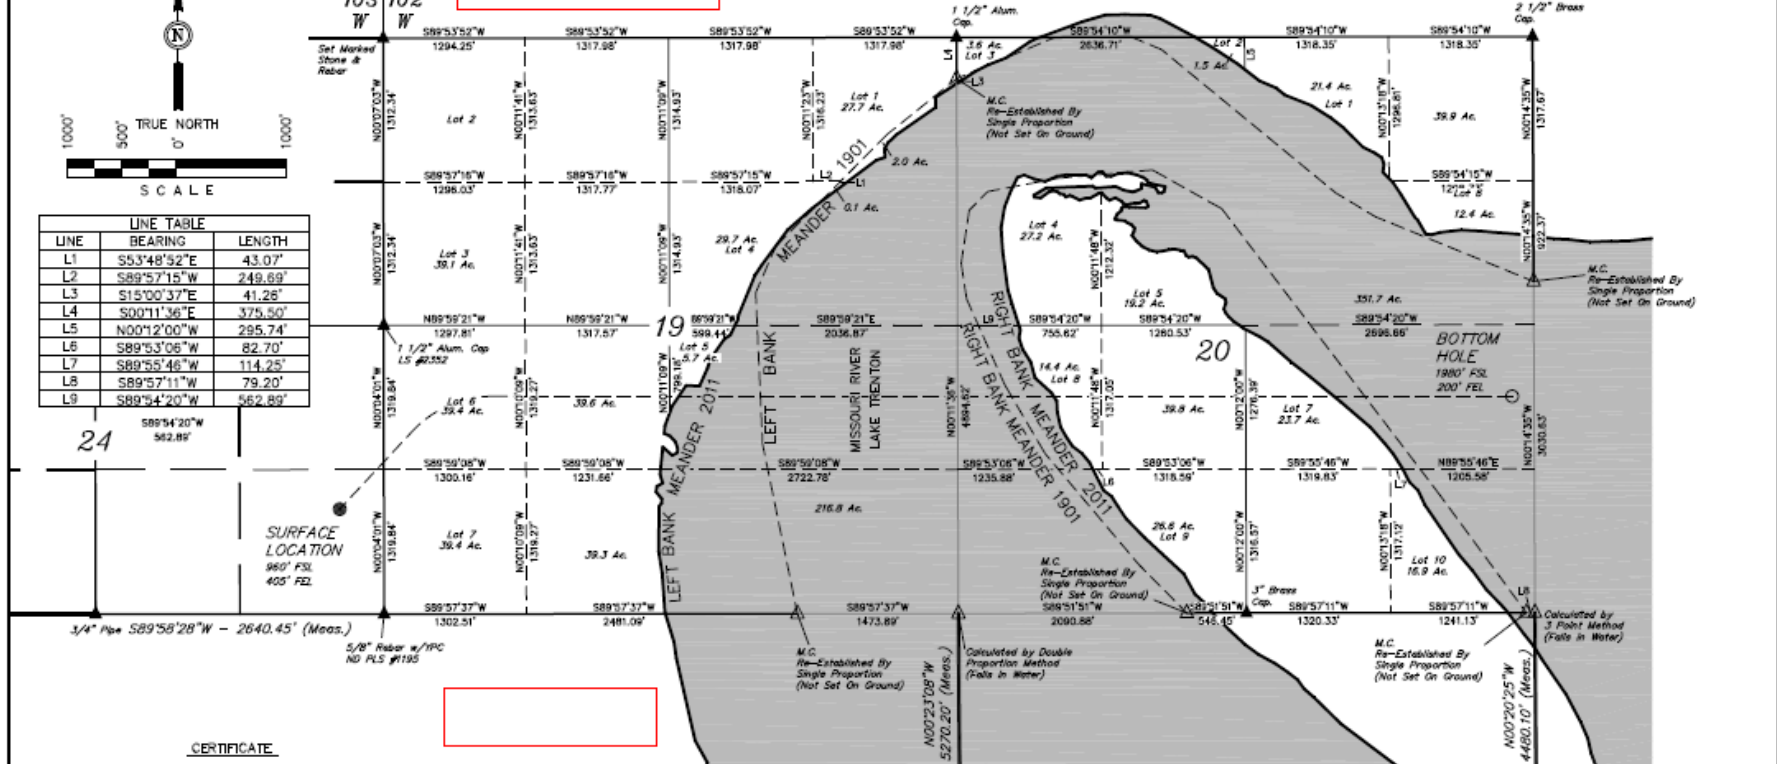

CERTIFICATE

I HEREBY CERTIFY THAT THIS PLAT CORRECTLY REPRESENTS WORK PERFORMED BY ME OR UNDER MY DIRECT SUPERVISION AND IS TRUE AND CORRECT TO THE BEST OF MY KNOWLEDGE AND BELIEF.

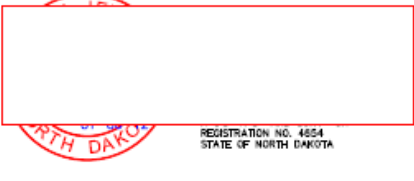


LEGEND:

- └─ = 90° SYMBOL
- = PROPOSED WELL HEAD.
- ▲ = SECTION CORNERS LOCATED.
- △ = SECTION CORNERS RE-ESTABLISHED. (Not Set on Ground)

[derived from: N.G.S. O.P.U.S. Solution REF FRAME: NAD_83(CORS99)(EPOCH 2002.0000)]

NAD 83 (TARGET BOTTOM HOLE)	NAD 83 (SURFACE LOCATION)
LATITUDE = 48°03'31.65" (48.058792)	LATITUDE = 48°03'21.73" (48.056036)
LONGITUDE = 103°49'14.85" (103.820761)	LONGITUDE = 103°51'52.85" (103.864661)
NAD 27 (TARGET BOTTOM HOLE)	NAD 27 (SURFACE LOCATION)
LATITUDE = 48°03'31.67" (48.058789)	LATITUDE = 48°03'21.85" (48.056044)
LONGITUDE = 103°49'13.10" (103.820306)	LONGITUDE = 103°51'51.11" (103.864197)

REVISED: 01-06-12 T.B.
 REVISED: 01-03-12 T.B.
 REVISED: 12-16-11 J.J.
 REVISED: 10-18-11

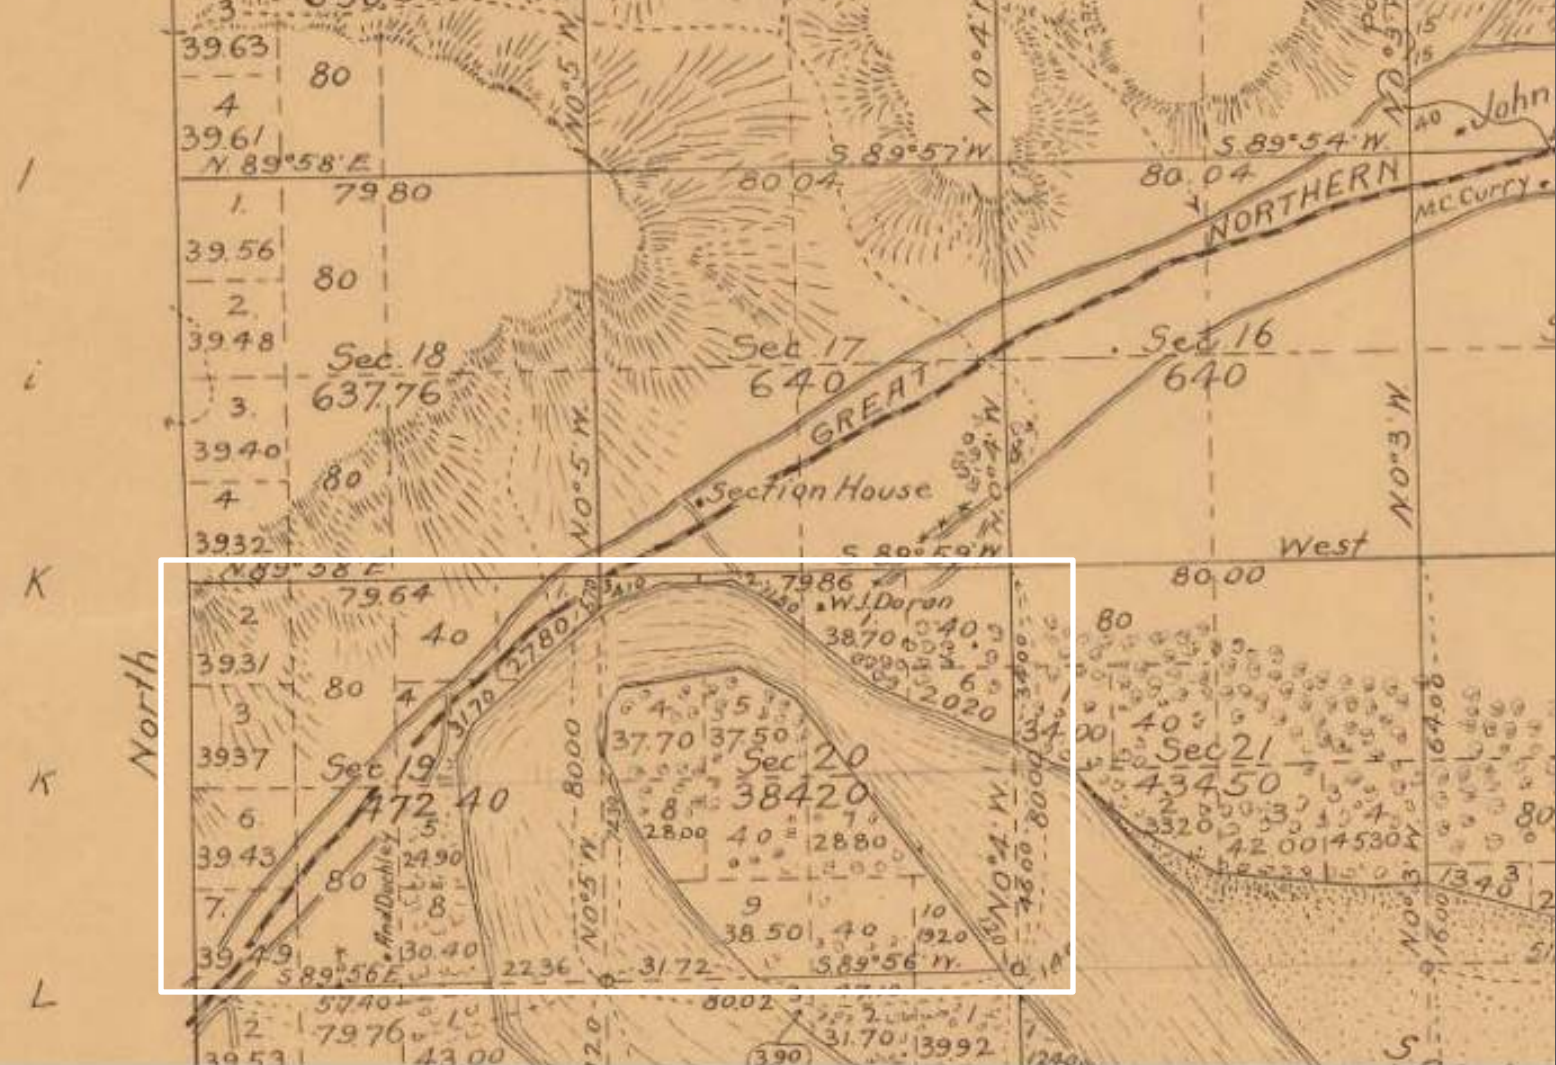

Riparian Issues: Ordinary High Water Mark

- ▣ Commission heard Case 15892. Brigham Vs. Hess per NDAC 43-02-03-16.2.
- ▣ Hess requested to suspend Brigham permit.
- ▣ Dispute of mineral acreage underlying Missouri River from OHWM. ND Dept. of Trust Lands owns minerals w/in ordinary high water mark of navigable lakes & streams.
 - Testimony provided.
 - ▣ Both Operators have similar experience in Bakken drilling and operating wells.

Ordinary High Water Mark Cont.

- ▣ Pursuant to NDAC Section 43-02-03-16.2, in deciding whether to revoke or limit a permit, if the amount of the interest owned by the permitholder and its partners is a majority of the ownership, the Commission will presume that the permit should be retained. However, if the amount of the interest owned by the owner seeking revocation or limitation and its supporters are a majority of the ownership, the Commission will presume that the permit should be revoked.
- ▣ Brigham owns 62% based on riparian land owners also claiming WI in 1280. Hess 59% owns or controls.
- ▣ The Commission does not have jurisdiction to settle the dispute of mineral ownership in this matter. The Commission concludes that Hess has not supplied sufficient evidence to overcome the presumption that Brigham holds a majority of the working interest in the spacing unit.
- ▣ Based on Working Interest: The Commission decided Brigham should retain the permit

Distance Restrictions and Notices

- ▣ Section Lines
- ▣ Notice issues for occupied dwellings
- ▣ Distance to an occupied dwelling regulated by NDIC
- ▣ Notice to stake a well.

Section Line Setback

- ▣ Well will not be permitted by NDIC which overlaps a section line within 33' of R/W.
- ▣ NDCC 24-06-28. Obstruction of section lines prohibited - Exception - Certain fences not considered obstructions - Obstructions and traffic safety hazards - Penalty.
 - *1. A person may not place or cause to be placed any permanent obstruction within the vertical plane of thirty-three feet [10.06 meters] of any section line or within the right of way of any highway, unless written permission is first secured from the board of county commissioners or the board of township supervisors, as appropriate. The permission must be granted where the section line has been closed pursuant to section 24-07-03 or where the topography of the land along the section line is such that in the opinion of the board of county commissioners or board of township supervisors, as the case may be, the construction of a road on the section line is impracticable.*

NDIC Occupied Dwelling restrictions

- ▣ Applicant (O&G operator) shall provide notice to the owner of any permanent occupied dwelling within one quarter mile. *Per NDCC 38-08-05.*
- ▣ continued...”the commission may not issue a drilling permit for an oil and gas well that will be located within 500 feet”
 - Noted on Form 1 & 1H.
 - If less than 500’ commission requires an affidavit and certified plat distances from the well to the occupied dwelling.

Notice to Stake Location

- ▣ Notice of Operations – per NDCC 38-11.1-04.1 “before the initial entry upon the land for activities including inspections, staking, surveys, measurements, ... shall provide at least seven days notice by registered mail or hand delivery to the surface owner unless waived by mutual agreement by both parties”.
 - Operator would typically take care of “notice”, but surveyor should verify that it has been done.

PLAT requirement Overview

- ▣ NDIC reviews all submitted plats with a critical eye.
- ▣ True North. (Not Grid or “assumed”).
- ▣ Monuments--Boundary Survey-KNOW YOUR SPACING UNIT.
- ▣ “Stamp” all plats to include well location, horizontal section plats, pad layout, cross-sections
- ▣ Riparian Issues – NDIC does not regulate.
- ▣ Surveyors are first on site so take care to examine the area. Let operator know about potential topo issues, landowner dwellings, etc.

Overview continued

-NDSPLS Recommended Guidelines for the Practice of Land Surveying in ND.

Section 51-1.10.

-File Corner Recordation in accordance with NDCC 47-20.1.

-Previously approved NDIC permits available online via Basic Service. View with GIS Map Server.

-NDIC expects plats to be filed accordance with NDCC 40-50.1.